

WAYNE

Essee

7-27-78

MISSISSIPPI BOARD OF WATER COMMISSIONERS
416 North State Street
Jackson, Mississippi 39201

WATER WELL DRILLERS LOG

RAILWAY WATER WELL SERVICE

Wayne

July 27 1978
date well completed

RT. firm name
WAYNESBORO, MISS. 39367

county well located

LANDOWNER:

Maggie Harris
Waynesboro Ms
(mailing address)

description of formations encountered

from to

SAND	0	5
CLAY	5	10
SAND	10	15
Blue Clay & Sandy Marl	15	55
Rock & Clay	55	65
Brown Clay	65	90
SANDY MARL	90	110
SAND	110	124

WELL LOCATION:

sec. 34 T 10 N R 18 E
15 miles NE of W'boro
(distance) (direction) (nearest town)

WELL PURPOSE: Home
(home, irrigation, municipal, industrial)

WELL COMPLETION DATA:

- (1) diameter (inches) 2"
- (2) total depth (feet) 124'
- (3) static water level (feet) 11' below top of ground
- (4) casing PVC 114' (material) (depth)
2" (size) If telescope see back.
- (5) screen 10' (length) 114' (depth to top)
2" PVC (size) (material)
- (6) pump 1/2 (HP) 4 (yield gpm)
110 AC (type power)
- (7) electric log No (yes or no)

(organization running log)

(8) how well bottom plugged

DRILLERS REMARKS:


RECEIVED

AUG 11 1978

MISS. Bd. OF WATER COMMISSIONERS

If well telescopes please sketch and show depths.

GROUND LEVEL

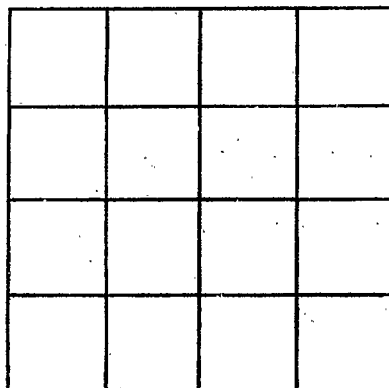

SECTION _____

Please indicate well location X.

ADDITIONAL INFORMATION

If more than one screen,
show locations of each on sketch.