

WAYNE

E 2007

3/23/78

MISSISSIPPI BOARD OF WATER COMMISSIONERS 416 North State Street Jackson, Mississippi 39201

WATER WELL DRILLERS LOG

March 23 1978 Porter Drilling & Pump Wayne date well completed firm name county well located

LANDOWNER: C.B. Altman Boy 556 Dubuissou Rd Slidell, La. 70458 (mailing address)

WELL LOCATION: sec. 34 T. 10 N. R. 5 11 miles NE 2 1/2 approx (distance) (direction) (nearest town)

WELL PURPOSE: none (home, irrigation, municipal, industrial)

- WELL COMPLETION DATA: (1) diameter (inches) 2 (2) total depth (feet) 390 (3) static water level (feet) 6 below top of ground (4) casing steel 7.5 (material) (depth) 2' (size) If telescope see back. (5) screen none used (length) (depth to top) (size) (material) (6) pump 1/3 (HP) 6 (yield gpm) elec. (type power) (7) electric log no (yes or no) (organization running log) (8) how well bottom plugged open

DRILLERS REMARKS:


Table with 3 columns: description of formations encountered, from, to. Rows include: clay 0-8, sand 8-20, clay 20-72, soft sand 72-76, med dark sand & clay 76-105, clay & sand 105-117, soft sand 117-120, clay & sand 120-140, clay 140-207, soft siltstone 207-220, clay, some sand 220-237, clay 237-300, sand 300-304, clay 304-317, sand & clay 317-323, clay 323-345, clay & sand 345-355, sand 355-357, clay 357-390. Also includes 34' 1" P.V.C down pipe.

RECEIVED APR 1 1978

MISS. BD. OF WATER COMM.

If well telescopes please sketch and show depths.

GROUND LEVEL

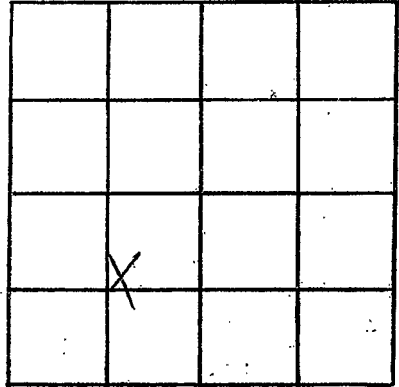

SECTION

34

Please indicate well location X.

ADDITIONAL INFORMATION

If more than one screen,
show locations of each on sketch.