

Wayne  
E. 2009  
6-28-79

MISSISSIPPI  
 BOARD OF WATER COMMISSIONERS  
 416 North State Street  
 Jackson, Mississippi 39201

WATER WELL DRILLERS LOG

June 28 1979 Porter Drilling Wayne  
 date well completed firm name county well located

LANDOWNER: John Mc Cain  
At 2 Box 253  
Waynesboro Miss.  
 (mailing address)

WELL LOCATION:  
 sec. B T. 100 R. 5 E.  
2 miles SE of Waynesboro  
 (distance) (direction) (nearest town)

WELL PURPOSE: home  
 (home, irrigation, municipal, industrial)

WELL COMPLETION DATA:  
 (1) diameter (inches) 2"  
 (2) total depth (feet) 180'  
 (3) static water level (feet) 54' (below/above top of ground)  
 (4) casing PVC 168'  
 (material) (depth)  
2" If telescope see back.  
 (size)  
 (5) screen 12' 168'  
 (length) (depth to top)  
2" cast S.S.  
 (size) (material)  
 (6) pump 1 1/2 8  
 (HP) (yield gpm)  
elec  
 (type power)  
 (7) electric log no  
 (yes or no)  
 (organization running log)  
 (8) how well bottom plugged  
2" sand shank

description of formations encountered	from	to
Clay	0	14
sand	14	20
Clay	26	26
rock	26	30
Clay	30	44
rock	44	45
Clay	45	51
rock	51	53
Clay	53	109
rock shell lig. clay	109	150
sand	150	152
Clay	152	168
sand some clay	168	174
Clay	174	176
med fine sand	176	180
Clay	180	248
rock lodges some sand	248	268
med sand	268	270
clay, rock lodges	270	285

94' 1 1/4" galv drop pipe

Miss. Board of Water Comm.


SEP 10 1979

RECEIVED

DRILLERS REMARKS:  
shell trap

If well telescopes please sketch and show depths.

GROUND LEVEL

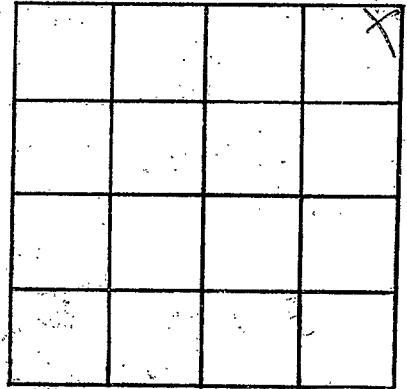

SECTION

13

Please indicate well location X.

ADDITIONAL INFORMATION

If more than one screen, show locations of each on sketch.