

Wayne  
E200  
8-3-79

MISSISSIPPI  
 BOARD OF WATER COMMISSIONERS  
 416 North State Street  
 Jackson, Mississippi 39201

WATER WELL DRILLERS LOG

Aug. 3 1979 Porter Drilling Wayne  
 date well completed firm name county well located

LANDOWNER: Ray McCallough  
Box 256  
Waynesboro Miss.  
 (mailing address)

WELL LOCATION:  
 sec. 19 T. 10 N. R. 5  
3 miles SE of Mathersville  
 (distance) (direction) (nearest town)

WELL PURPOSE: Home  
 (home, irrigation, municipal, industrial)

WELL COMPLETION DATA:  
 (1) diameter (inches) 2"  
 (2) total depth (feet) 169'  
 (3) static water level (feet) 48' below above top of ground.  
 (4) casing PVC 158'  
 (material) (depth)  
2" If telescope see back.  
 (size)  
 (5) screen 11' 158'  
 (length) (depth to top)  
2" ball SS  
 (size) (material)  
 (6) pump 1 6  
 (HP) (yield gpm)  
elec  
 (type power)  
 (7) electric log no  
 (yes or no)  
 (organization running log)

(8) how well bottom plugged 2" sand shock

DRILLERS REMARKS:  
shel top

description of formations encountered	from	to
rock strator	0	10
sand & clay	10	28
rock strator	28	63
clay	63	113
shel bed clay sand	113	134
clay some sand	134	150
clay	150	157
sand some clay	157	169
strat on clay		

62' 1" P.V.C drop pipe


Miss. Board of Water Comm.

SEP 10 1979

RECEIVED

If well telescopes please sketch and show depths.

GROUND LEVEL

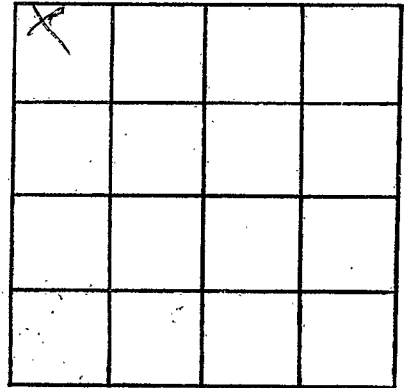

SECTION 19

Please indicate well location X.

ADDITIONAL INFORMATION

If more than one screen,  
show locations of each on sketch.