

MISSISSIPPI DEPARTMENT OF NATURAL RESOURCES

Bureau of Land and Water Resources

Southport Mall

P.O. Box 10631

Jackson, Mississippi 39209

WATER WELL DRILLERS LOG

WAYNE
E 200
4-13-81

4-13-81
date well completed

McDonald & Hill
firm name

Wayne
county well located

LANDOWNER:	description of formations encountered	from	to
Tommy Brown	Clay	0	10
Rt # 2 Box 149 Waynesboro (mailing address)	sand & clay	10	25
WELL LOCATION: sec. 16 T-10 N R-5 E 20 miles NE of Waynesboro (distance) (direction) (nearest town)	sand, shale	25	45
	blue shale	45	95
	sandy	95	100
WELL PURPOSE: home (home, irrigation, municipal, industrial)	sandy shale, fine sand pebbles	100	150
WELL COMPLETION DATA:			
(1) diameter (inches) 4"	Med sand	150	165
(2) total depth (feet) 110.5			
(3) static water level (feet) 100' below top of ground.			
(4) casing PVC 160 (material) (depth) 4' (size) if telescope see back.			
(5) screen 5' 160 to 165' (length) (depth to top) 4' (size) PVC (material)			
(6) pump 1/2 690 m (HP) (yield gpm) F (type power)			
(7) electric log (yes or no) (organization running log)			
(8) how well bottom plugged No We			
DRILLERS REMARKS:			


DEPT. OF NATURAL RESOURCES
BUREAU OF LAND & WATER RESOURCES

APR 20 1981

RECEIVED

If well telescopes please
sketch and show depths.

GROUND LEVEL

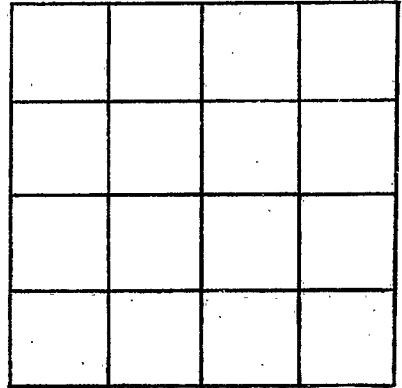

SECTION _____

Please indicate well location X.

ADDITIONAL INFORMATION

If more than one screen,
show locations of each on sketch.