

Wayne
E
2014

MISSISSIPPI
BOARD OF WATER COMMISSIONERS
416 North State Street
Jackson, Mississippi 39201

WATER WELL DRILLERS LOG

Sept. 15 1983 C.P. Clark Water Wells Wayne
date well completed firm name county well located

LANDOWNER: Cleveland Brown
Route 2, Box 315
Waynesboro, MS 39367
(mailing address)

WELL LOCATION:
sec. 9 T. 10 N R. 5 E
2 1/2 miles NW of Emory
(distance) (direction) (place, town)

WELL PURPOSE: Home
(home, irrigation, municipal, industrial)

- WELL COMPLETION DATA:
- (1) diameter (inches) 2
 - (2) total depth (feet) 103'
 - (3) static water level (feet) 45' below top of ground.
 - (4) casing Galv. 93' (material) (depth)
 - (size) If telescope see back.
 - (5) screen 10' 93' (length) (depth to top)
 - 2" Stainless Steel (size) (material) .005
 - (6) pump 1 HP 4 (yield gpm)
 - 230V. 14 (type power)
 - (7) electric log no (yes or no)
 - (organization running log)
 - (8) how well bottom plugged BWW

description of formations encountered	from	to
Sandy top soil	0	1
Sandy clay	1	8
Sandy clay	8	11
Gray clay	11	47
Rock	47	49
Clay	49	51
Hard claystone	51	52
Clay	52	63
Sandy clay & silt	63	70
Sandy silt clay & silt	70	75
Brown clay	75	82
Muddy sandy clay	82	92
Sandy clay & glauconite	92	105
Sandy clay	105	106

DEPT. OF NATURAL RESOURCES
BUREAU OF LAND & WATER RESOURCES


OCT 26 1983

RECEIVED

DRILLERS REMARKS:
Packed well w/ sand
SAGet on 84 ft of 1 1/4" galv.

If well telescopes please sketch and show depths.

GROUND LEVEL

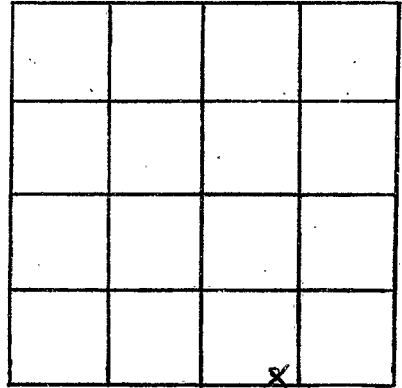

SECTION 9

Please indicate well location X.

ADDITIONAL INFORMATION

If more than one screen,
show locations of each on sketch.