

MISSISSIPPI DEPARTMENT OF NATURAL RESOURCES

Bureau of Land and Water Resources

Southport Mall

P.O. Box 10631

Jackson, Mississippi 39209

WATER WELL DRILLERS LOG

Wayne
E 2015
5/9/83

5-9-83 date well completed 19 McDonald + Hill firm name Wayne county well located

LANDOWNER:	description of formations encountered	from	to
R.H. Jones	clay	0	10
Rt # 3 Wainiesboro (mailing address)	sand st clay	10	25
WELL LOCATION: sec. 19 T 10 N R SE 3 miles SE of Mathews (distance) (direction) (nearest town)	sandy shale	25	60
	blue shale	60	100
WELL PURPOSE: (home, irrigation, municipal, industrial)	sandy shale & shells	100	120
WELL COMPLETION DATA:	Brown shale & fine sand	120	170
(1) diameter (inches) 4"	sand & shale	170	185
(2) total depth (feet) 185'			
(3) static water level (feet) 120' below top of ground.			
(4) casing PVC, 180' (material) (depth) 4" if telescope see back. (size)			
(5) screen 5, 180 to 185 (length) (depth to top) 4" PVC (size) (material)			
(6) pump 3/4 5 gpm (HP) (y/efd gpm) E (type power)			
(7) electric log (yes or no) (organization running log)			
(8) how well bottom plugged value			
DRILLERS REMARKS:			


DEPT. OF NATURAL RESOURCES
BUREAU OF LAND & WATER RESOURCES

MAY 16 1983

RECEIVED

If well telescopes please sketch and show depths.

GROUND LEVEL

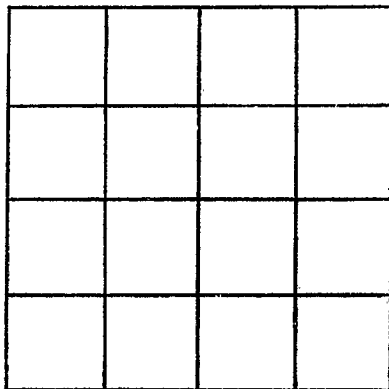

SECTION _____

Please indicate well location X.

ADDITIONAL INFORMATION

If more than one screen,
show locations of each on sketch.