

MISSISSIPPI DEPARTMENT OF NATURAL RESOURCES

Bureau of Land and Water Resources

Southport Mall

P.O. Box 10631

Jackson, Mississippi 39209

WATER WELL DRILLERS LOG

Wayne  
E. Jone

8-29-83  
date well completed

McDonald & Hill  
firm name

county well located

LANDOWNER:	description of formations encountered	from	to
Dialney Howell			
Rt # 2 Box 117, Waverly, Mo	shale	12	60
(mailing address)			
WELL LOCATION:	Sandy Shale w/ st Ranks	60	80
sec. 34 T 10 N R 18 E	shale	80	100
S W			
2 miles N of Dialney	fine sand & shell	100	120
(distance) (direction) (nearest town)			
WELL PURPOSE: Home	sand & shale	120	145
(home, irrigation, municipal, industrial)			
WELL COMPLETION DATA:			
(1) diameter (inches) 2"			
(2) total depth (feet) 145'			
(3) static water level (feet) 5' below top of ground.			
(4) casing PVC 140' (material) (depth)			
2" (size) if telescope see back.			
(5) screen 5' 140 to 145' (length) (depth to top)			
2" (size) PVC (material)			
(6) pump 1/2 (HP) 60 gpm (yield gpm)			
F (type power)			
(7) electric log (yes or no)			
(organization running log)			
(8) how well bottom plugged Value			

DRILLERS REMARKS:


MISSISSIPPI DEPARTMENT OF NATURAL RESOURCES  
BUREAU OF LAND & WATER RESOURCES

SEP - 6 1983

RECEIVED

If well telescopes please  
sketch and show depths.

GROUND LEVEL

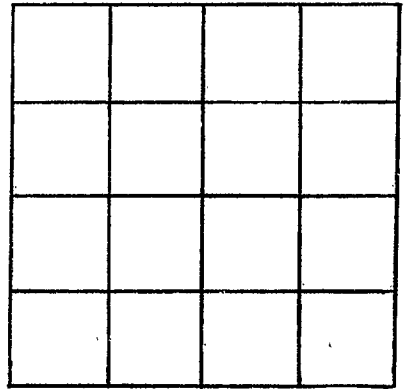

SECTION \_\_\_\_\_

Please indicate well location X.

ADDITIONAL INFORMATION

If more than one screen,  
show locations of each on sketch.