

MISSISSIPPI DEPARTMENT OF NATURAL RESOURCES

Bureau of Land and Water Resources

Southport Mall

P.O. Box 10631

Jackson, Mississippi 39209

WATER WELL DRILLERS LOG

WAYNE
E 2017

Sept 4 1985 Porter Drilling & Log Wayne
 date well completed firm name county well located

LANDOWNER: Selen Anderson
At 2 Magnolia, Ms
 (mailing address)

WELL LOCATION:
 sec 28 T 10 N R 5 E
2 miles NW of Downal
 (distance) (direction) (nearest town)

WELL PURPOSE: Home
 (home, irrigation, municipal, industrial)

WELL COMPLETION DATA:

(1) diameter (inches) 2"

(2) total depth (feet) 122'

(3) static water level (feet) 2 below above top of ground.

(4) casing PVC 117'
 (material) (depth)
2" if telescope see back.
 (size)

(5) screen 5' 117'
 (length) (depth to top)
2" solid P.V.C.
 (size) (material)

(6) pump 1 8
 (HP) (yield gpm)
elec.
 (type power)

(7) electric log no
 (yes or no)
 (organization running log)

(8) how well bottom plugged:
2' sand wash on the

description of formations encountered	from	to
<u>clay & silt</u>	<u>0</u>	<u>11</u>
<u>clay</u>	<u>11</u>	<u>61</u>
<u>silt & clay</u>	<u>67</u>	<u>70</u>
<u>clay</u>	<u>70</u>	<u>92</u>
<u>fine sand & shell</u>	<u>93</u>	<u>98</u>
<u>fine black limestone shell</u>	<u>98</u>	<u>105</u>
<u>fine sand & shell</u>	<u>105</u>	<u>107</u>
<u>fine black sand & shell</u>	<u>107</u>	<u>114</u>
<u>hard fairly clean sand</u>	<u>114</u>	<u>122</u>
<u>60' 1" P.V.C. deep pipe</u>		

RECEIVED


NOV 22 1985

DRILLERS REMARKS:
210' 4" surface casing

Department of Natural Resources
 Bureau of Land and Water Resources

If well telescopes please sketch and show depths.

GROUND LEVEL

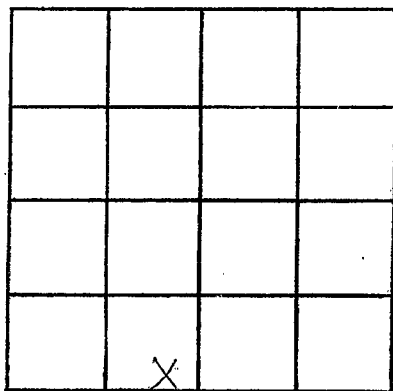

SECTION 28

Please indicate well location X.

ADDITIONAL INFORMATION

If more than one screen,
show locations of each on sketch.