

MISSISSIPPI DEPARTMENT OF NATURAL RESOURCES

Bureau of Land and Water Resources

Southport Mall

P.O. Box 10631

Jackson, Mississippi 39209

WATER WELL DRILLERS LOG

WAYNE
E 2008

9/16

date well completed

1986 CARB'S WELL SER

firm name

WAYNE

county well located

LANDOWNER: Jim

SANDERSON, RT 2.

WAYNES BORO, MS,
(mailing address)

description of formations encountered

from

to

TOP SOIL

0 1

SD. & CHALK

1 18

BLUE CLAY

18 58

SHELL & BRK SD.

58 74

BROWN CLAY

74 85

ROCK & SD.

85 95

SD SHELL & CLAY

95 120

WELL LOCATION:

sec. 5 T 10 N S R 5 E

miles E of WAYNESBORO
(distance) (direction) (nearest town)

WELL PURPOSE: HOME

(home, irrigation, municipal, industrial)

WELL COMPLETION DATA:

- (1) diameter (inches) 2'
- (2) total depth (feet) 121
- (3) static water level (feet) 3 below top of ground.

- (4) casing P.V.C. 40' (material) (depth)
2" (size) if telescope see back.

- (5) screen OPEN END (length) (depth to top)
(size) (material)

- (6) pump 1 (HP) 7 (yield gpm)
ELEC (type power)

- (7) electric log NO (yes or no)

(organization running log)

- (8) how well bottom plugged OPEN END ROCK WELL

DRILLERS REMARKS:


RECEIVED

OCT 20 1986

Department of Natural Resources
Bureau of Land & Water Resources

If well telescopes please sketch and show depths.

GROUND LEVEL

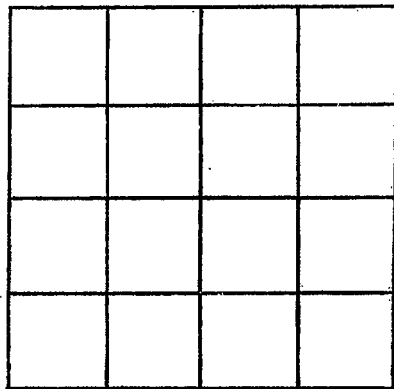

SECTION _____

Please indicate well location X.

ADDITIONAL INFORMATION

If more than one screen,
show locations of each on sketch.