

WAYNE
F14

MISSISSIPPI BOARD OF WATER COMMISSIONERS

1-28-62

WATER WELL DRILLERS LOG

Date: Jan 28, 1962, Driller: D. N. Porter Lon County Wayne
Elev. 398 30 (Name)

(1) Owner of Land: Wayne County School Sys.
(Name)
McBiel School @ 1 Shubuta
(Address)

(2) Location: SW 1/4, NE 1/4, Sec. 13 T28R9E3
15 miles west, of Waynesboro,
(distance) (direction) (Nearest Town)

(3) Topography: hilly
(Hilly) (Flat) (Level)

(4) Purpose of Well: school
(Domestic Irrigation
Municipal, Industrial, Other)

Description & Color of Materials Sand, Clay, Red Clay, Shell, etc.	Thick- ness Feet	Depth Feet
<u>red clay</u>	<u>15</u>	<u>15</u>
<u>sand</u>	<u>7</u>	<u>22</u>
<u>chuck</u>	<u>2</u>	<u>24</u>
<u>rock</u>	<u>1</u>	<u>25</u>
<u>Chalk with stratus</u>	<u>110</u>	
<u>of rock</u>		<u>135</u>
<u>sand fine to medium</u>	<u>33</u>	<u>168</u>
<u>with last 9' course</u>		
<u>stopped while still in</u>		
<u>course sand</u>		


Information upon completion of well:

- (1) Diameter 2' inches.
- (2) Total Depth 168' feet.
- (3) Water Level 96' feet below top of ground.
- (4) Cased to 162', Size 2'
- (5) Screen: Size 1 1/4", Length 5'
Johnson S.S.
- (6) Were any formations sealed against pollution?
no

If YES depth of formation _____

Why _____

Drillers Remarks: _____

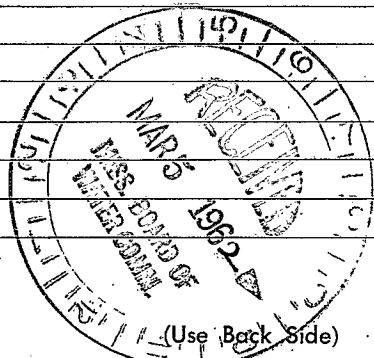

(Use Back Side)

Well No.

