

WAYNE MISSISSIPPI BOARD OF WATER COMMISSIONERS

F15

7-26-62

WATER WELL DRILLERS LOG

Date: July 26, 1962, Driller: Porter Drilling & Pump Co. Wayne
 30 (Name)

(1) Owner of Land:	Description & Color of Materials Sand, Clay, Red Clay, Shell, etc.	Thick- ness Feet	Depth Feet
<u>Wesler</u> (Name) <u>At 1 Laurel, Miss</u> (Address)	<u>red clay</u>	<u>15</u>	<u>15</u>
(2) Location: <u>SW 1/4, NW 1/4, Sec. 31 T 9 R 9,</u>	<u>sand</u>	<u>7</u>	<u>22</u>
<u>17 miles west</u> , of <u>Waynesboro,</u> (distance) (direction) (Nearest Town)	<u>chalk</u>	<u>4</u>	<u>26</u>
(3) Topography: <u>Hilly</u> (Hilly) (Flat) (Level)	<u>sand mixed chalk</u>	<u>5</u>	<u>31</u>
(4) Purpose of Well: <u>Domestic</u> (Domestic Irrigation Municipal, Industrial, Other)			


Information upon completion of well:

- (1) Diameter 2" inches.
- (2) Total Depth 31 feet.
- (3) Water Level 18 feet below top of ground.
- (4) Cased to 25, Size 2"
- (5) Screen: Size 1/4, Length 6
- (6) Were any formations sealed against pollution?
 yes, no.

If YES depth of formation _____

Why _____

Drillers Remarks: _____

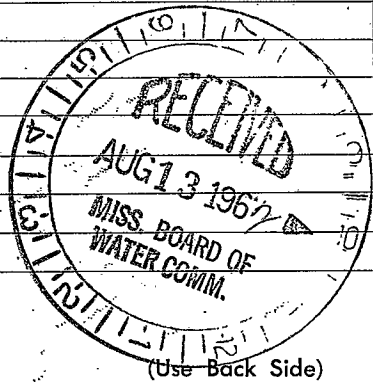

Well No.

