

WAYNE MISSISSIPPI BOARD OF WATER COMMISSIONERS

F 18

11-12-64

WATER WELL DRILLERS LOG

Date: Nov. 12, 1964, Driller: Porter Drilling & Pump County: Wayne
 3 P (Name)

(1) Owner of Land: Lester Butler
 (Name)
Box 1 Laurel, Miss.
 (Address)

(2) Location: NW 1/4, SE 1/4, Sec. 2, T9R9,
14 miles west of Waynesboro
 (distance) (direction) (Nearest Town)

(3) Topography: Hilly
 (Hilly) (Flat) (Level)

(4) Purpose of Well: domestic
 (Domestic Irrigation
 Municipal, Industrial, Other)

Description & Color of Materials Sand, Clay, Red Clay, Shell, etc.	Thick- ness Feet	Depth Feet
<u>red clay</u>	<u>4</u>	<u>4</u>
<u>mixed chalk</u>	<u>36</u>	<u>40</u>
<u>sand</u>	<u>2</u>	<u>42</u>
<u>chalk</u>	<u>10</u>	<u>52</u>
<u>chalky sand</u>	<u>7</u>	<u>59</u>
<u>lumpy chalk</u>	<u>36</u>	<u>95</u>
<u>soft blue chalk mixed with a little sand</u>	<u>10</u>	<u>105</u>
<u>blue chalk</u>	<u>13</u>	<u>118</u>
<u>med to coarse hard sand</u>	<u>14</u>	<u>132</u>
<u>stayed white still in sand but getting loose</u>		

Information upon completion of well:

(1) Diameter 2" inches.

(2) Total Depth 132' feet.

(3) Water Level 47' feet below top of ground.


(4) Cased to 126', Size 2"

(5) Screen: Size 1 1/4", Length 6'
60 ga.

(6) Were any formations sealed against pollution?
no

If YES depth of formation _____
 Why _____

Drillers Remarks: _____

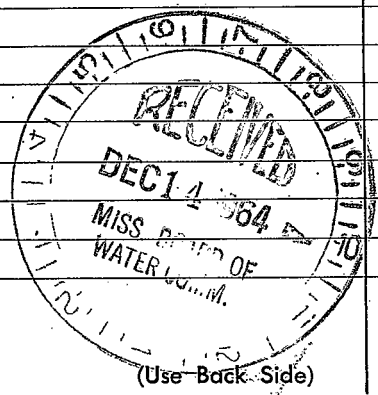

Well No. _____

