

F19

7-66

WATER WELL DRILLERS LOG

Date: 7/27, 1966, Driller: C. J. Clark County Wayne
3 P (Name)

(1) Owner of Land: C. H. Johnson
(Name)
Rt # 3 Shubitta
(Address)

(2) Location: NE 1/4, NW 1/4, Sec. 12 T. 9 R. 9
4 miles South of Euclitta
(distance) (direction) (Nearest Town)

(3) Topography: _____
(Hilly) (Flat) (Level)

(4) Purpose of Well: Chicken Houses
(Domestic Irrigation Municipal, Industrial, Other)


Description & Color of Materials Sand, Clay, Red Clay, Shell, etc.	Thick- ness Feet	Depth Feet
<u>0-50 Clay</u>	<u>50</u>	
<u>50-107 Sand</u>	<u>57</u>	

Information upon completion of well:

- (1) Diameter 2 inches.
- (2) Total Depth 107 feet.
- (3) Water Level 48 feet below top of ground.
- (4) Cased to 102, Size 2
- (5) Screen: Size 1 1/4, Length 55.5
- (6) Were any formations sealed against pollution?
 yes, no.

If YES depth of formation _____
 Why _____

Drillers Remarks: This is a log on 2 wells drilled 30 ft apart

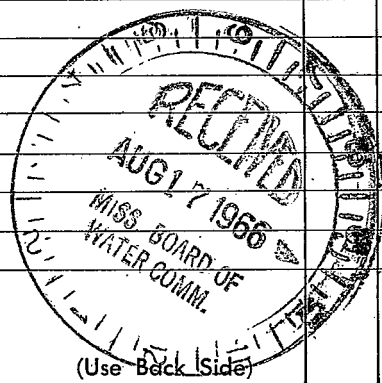

Well No.

