

3P

MISSISSIPPI  
 BOARD OF WATER COMMISSIONERS  
 416 North State Street  
 Jackson, Mississippi 39201

WATER WELL DRILLERS LOG

Wayne  
 720  
 12-67

12-15 1967 Roy Wilcox Wayne  
 date well completed firm name county well located

LANDOWNER: Horace Cooley  
Rt 1 Box 98  
Shubuta  
 (mailing address)


description of formations encountered	from	to
<u>loamy clay</u>	<u>0</u>	<u>20</u>
<u>clay</u>	<u>20</u>	<u>80</u>
<u>sand</u>	<u>80</u>	<u>110</u>

WELL LOCATION:  
 sec. 14 T. 9 N. R. 9 E  
S  
15 miles N.E. of Lauder  
 (distance) (direction) (nearest town)

WELL PURPOSE: Home  
 (home, irrigation, municipal, industrial)


- WELL COMPLETION DATA:
- (1) diameter (inches) 2
  - (2) total depth (feet) 110
  - (3) static water level (feet) 50 below top of ground.
  - (4) casing galv, 105  
 (material) (depth)
  - if telescope see back.  
 (size)
  - (5) screen 5ft, 105  
 (length) (depth to top)  
1/4, st st  
 (size) (material)
  - (6) pump 3/4 7  
 (HP) (yield gpm)  
RCA  
 (type power)
  - (7) electric log no  
 (yes or no)
  - (organization running log)
  - (8) how well bottom plugged Leash Walker

DRILLERS REMARKS:

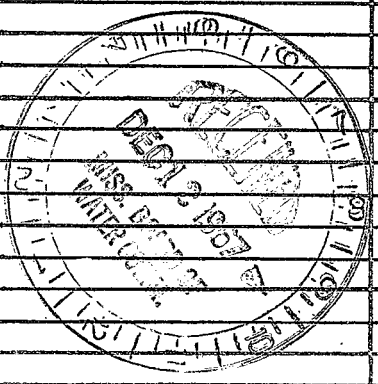

If well telescopes please sketch and show depths.

GROUND LEVEL

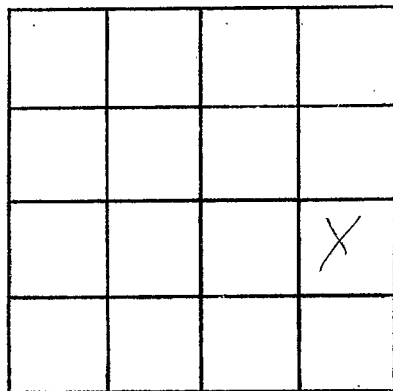

SECTION 14

Please indicate well location X.

ADDITIONAL INFORMATION

If more than one screen, show locations of each on sketch.