

WAYNE
F 21
4-68

MISSISSIPPI
BOARD OF WATER COMMISSIONERS
416 North State Street
Jackson, Mississippi 39201

WATER WELL DRILLERS LOG

4-23 1968 Rockwell St Wayne
date well completed firm name county well located

LANDOWNER: Stanton mikes

description of formations encountered	from	to
	<u>sandy clay</u>	<u>0</u>
<u>clay</u>	<u>10</u>	<u>40</u>
<u>sandy clay</u>	<u>40</u>	<u>60</u>
<u>fine sand</u>	<u>60</u>	<u>70</u>
<u>sand</u>	<u>70</u>	<u>86</u>

Rt 6
Laurel Miss
(mailing address)


WELL LOCATION:
sec. 8 T. 9 N. R. 9 E
15 miles SE of Laurel
(distance) (direction) (nearest town)

WELL PURPOSE: Chicken house
(home, irrigation, municipal, industrial)

WELL COMPLETION DATA:


- (1) diameter (inches) 2 in
- (2) total depth (feet) 86
- (3) static water level (feet) 38 below above top of ground.
- (4) casing galv, 81
(material) (depth)
if telescope see back.
(size)
- (5) screen 5 ft,
(length) (depth to top)
1/2, St Steel
(size) (material)
- (6) pump 1/2, 7
(HP) (yield gpm)
R&A
(type power)
- (7) electric log no
(yes or no)
(organization running log)
- (8) how well bottom plugged wash water

DRILLERS REMARKS:

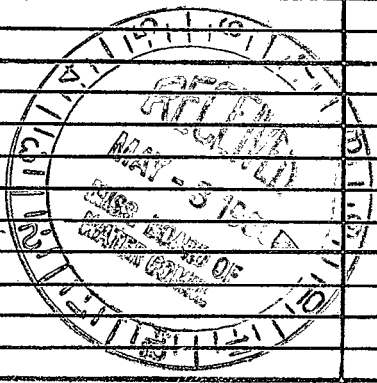

If well telescopes please sketch and show depths.

GROUND LEVEL

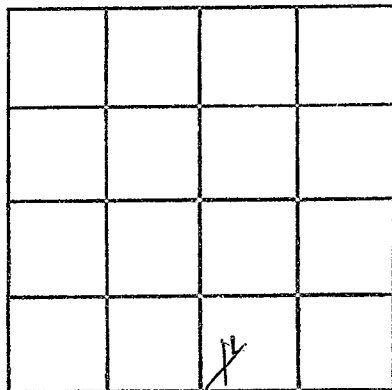

SECTION 8

Please indicate well location X.

ADDITIONAL INFORMATION

If more than one screen, show locations of each on sketch.