

WAYNE
F22
4-68

MISSISSIPPI
BOARD OF WATER COMMISSIONERS
416 North State Street
Jackson, Mississippi 39201

WATER WELL DRILLERS LOG

4 27 1968 Rayview Wayne
date well completed firm name county well located

LANDOWNER: Donald West
Rt 1
Laurel Miss
(mailing address)

description of formations encountered	from	to
<u>Sandy clay</u>	<u>0</u>	<u>14</u>
<u>clay</u>	<u>14</u>	<u>40</u>
<u>sand</u>	<u>40</u>	<u>76</u>

WELL LOCATION:
sec 32 T 9 N R 9 E
15 miles E of Laurel
(distance) (direction) (nearest town)


WELL PURPOSE: home
(home, irrigation, municipal, industrial)

- WELL COMPLETION DATA:
- (1) diameter (inches) 2
 - (2) total depth (feet) 75
 - (3) static water level (feet) 35 below above top of ground.
 - (4) casing galv, 70
(material) (depth)
_____ if telescope see back.
(size)
 - (5) screen 5, 70
(length) (depth to top)
1/4, St. Steel
(size) (material)
 - (6) pump 3/4, 9
(HP) (yield gpm)
R-C-A
(type power)
 - (7) electric log No
(yes or no)

(organization running log) _____

(8) how well bottom plugged crushed

DRILLERS REMARKS:

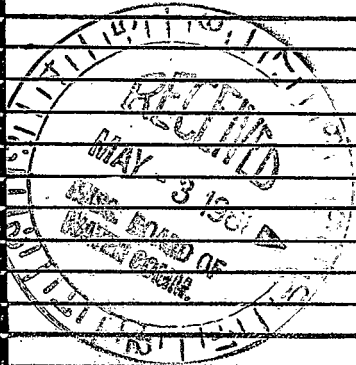

If well telescopes please sketch and show depths.

GROUND LEVEL

		X	

SECTION 33

Please indicate well location X.

ADDITIONAL INFORMATION

If more than one screen, show locations of each on sketch.