

MISSISSIPPI
BOARD OF WATER COMMISSIONERS
416 North State Street
Jackson, Mississippi 39201

WATER WELL DRILLERS LOG

Wayne
Clark

WAYNE
F 23
5-68

5-2 1968 Roy West firm name county well located

LANDOWNER: R.W. Brasier

description of formations encountered

from to

Rt 3
Shubuta Miss
(mailing address)

sand 0 26
Blue clay 26 90
rock 90 95
rock and Blue clay 95 158

WELL LOCATION:

sec. 23 T. 9 N. N R. 9 W. E
10 miles East of Hattiesburg Miss
(distance) (direction) (nearest town)

WELL PURPOSE: home
(home, irrigation, municipal, industrial)

WELL COMPLETION DATA:

- (1) diameter (inches) 2
- (2) total depth (feet) 158
- (3) static water level (feet) 57 below top of ground.
- (4) casing galv 158 (material) (depth)
- (size) if telescope see back.
- (5) screen none (length) (depth to top)
- (size) (material)
- (6) pump 1/2 6 gal (HP) (yield gpm)
- Rea (type power)
- (7) electric log no (yes or no)


(organization running log)
(8) how well bottom plugged open end

DRILLERS REMARKS:

MAY 22 1968
MISS. REG. OFF.
JACKSON, MISS.

If well telescopes please sketch and show depths.

GROUND LEVEL

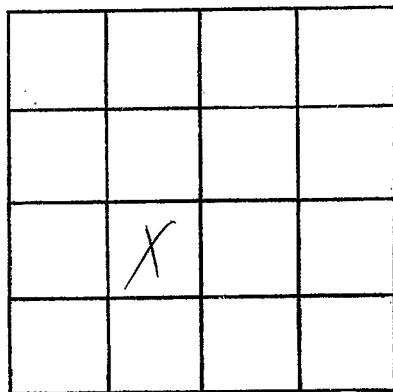

SECTION 23

Please indicate well location X.

ADDITIONAL INFORMATION

If more than one screen,
show locations of each on sketch.