

MISSISSIPPI
BOARD OF WATER COMMISSIONERS
416 North State Street
Jackson, Mississippi 39201

CODED

WATER WELL DRILLERS LOG

Wayne
F 24
8-68

8-14-1968 Roy West Wayne
date well completed firm name county well located

LANDOWNER Bennis Waters
Rt 1 Laurel
Miss
(mailing address)

description of formations encountered	from	to
<u>sandy clay</u>	<u>0</u>	<u>30</u>
<u>sand</u>	<u>30</u>	<u>70</u>

WELL LOCATION:
sec. 32 T 9 N R 9 E
S W
14 miles E of Laurel
(distance) (direction) (nearest town)

WELL PURPOSE: home
(home, irrigation, municipal, industrial)

WELL COMPLETION DATA:
(1) diameter (inches) 2 in
(2) total depth (feet) 70
(3) static water level (feet) 30 below above
top of ground.
(4) casing plastic, 65
(material) (depth)

_____ if telescope see back.
(size)
(5) screen 5 ft, 65
(length) (depth to top)
1/4", 12 steel
(size) (material)


(6) pump 1 12
(HP) (yield gpm)
R.E.A.
(type power)

(7) electric log no
(yes or no)

(organization running log)


(8) how well bottom plugged wash clean

DRILLERS REMARKS: _____

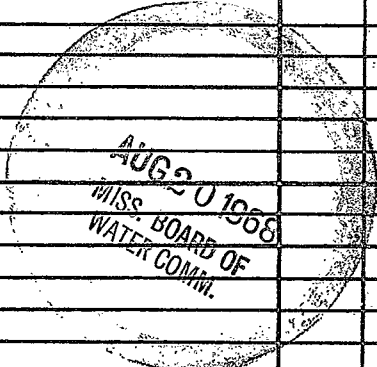

If well telescopes please sketch and show depths.

GROUND LEVEL

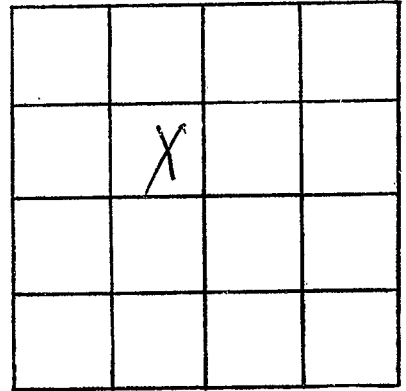

SECTION 32

Please indicate well location X.

ADDITIONAL INFORMATION

If more than one screen, show locations of each on sketch.