

CODED

MISSISSIPPI
BOARD OF WATER COMMISSIONERS
416 North State Street
Jackson, Mississippi 39201

WATER WELL DRILLERS LOG

Wayne
F 25
7-68

7.20 1968 Ray West Wayne
date well completed firm name county well located

LANDOWNER: Gronville Sellers
Pt. 1 Laurel
(mailing address)

description of formations encountered	from	to
<u>clay</u>	<u>0</u>	<u>15</u>
<u>sand</u>	<u>15</u>	<u>50</u>

WELL LOCATION:
sec. 34 T 9 N S R 9 E W
(distance) miles _____ of _____ (direction) (nearest town)

WELL PURPOSE: home
(home, irrigation, municipal, industrial)


WELL COMPLETION DATA:

- (1) diameter (inches) 2 in
- (2) total depth (feet) 50
- (3) static water level (feet) 20 below above top of ground.
- (4) casing galv, 45,
(material) (depth)
- _____ If telescope see back.
(size)
- (5) screen 5 ft, 45
(length) (depth to top)
- 1 1/2, _____
(size) (material)
- (6) pump 1 12
(HP) (yield gpm)
- REA
(type power)
- (7) electric log no
(yes or no)

_____ (organization running log)


(8) how well bottom plugged wash

DRILLERS REMARKS:

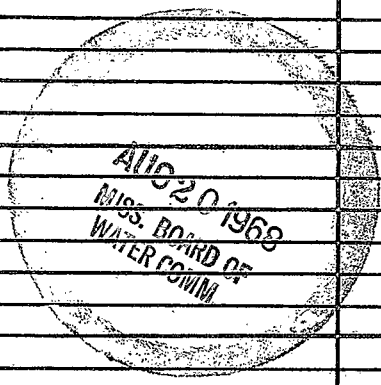

If well telescopes please sketch and show depths.

GROUND LEVEL

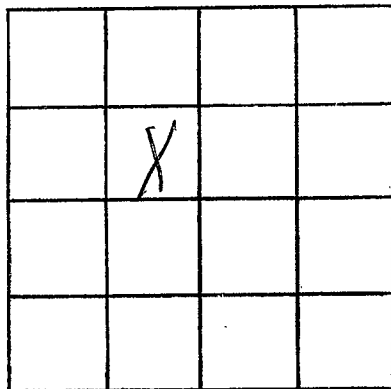

SECTION 34

Please indicate well location X.

ADDITIONAL INFORMATION

If more than one screen, show locations of each on sketch.