

Wayne
7-26
12-16-68

MISSISSIPPI
BOARD OF WATER COMMISSIONERS
416 North State Street
Jackson, Mississippi 39201

CODED

WATER WELL DRILLERS LOG

12 16 1968 Ray West Wayne
date well completed firm name county well located

LANDOWNER:	description of formations encountered	from	to
<u>Rt 1</u>	<u>clay</u>	<u>0</u>	<u>8</u>
<u>Laurel Miss</u>	<u>Sandy clay</u>	<u>8</u>	<u>30</u>
(mailing address)	<u>clay</u>	<u>30</u>	<u>80</u>
	<u>Sand</u>	<u>89</u>	<u>97</u>

WELL LOCATION:
sec. 22 T 9 N R. 9 E
1.8 miles E of Laurel
(distance) (direction) (nearest town)

WELL PURPOSE: home
(home, irrigation, municipal, industrial)

- WELL COMPLETION DATA:
- (1) diameter (inches) 2
 - (2) total depth (feet) 97
 - (3) static water level (feet) 40 ^{below} / _{above} top of ground.
 - (4) casing galv. 92
(material) (depth)
 - (size) if telescope see back.
 - (5) screen 5 92
(length) (depth to top)
 - 1/4 St Steel
(size) (material)
 - (6) pump 3/4 8
(HP) (yield gpm)
 - Reo
(type power)
 - (7) electric log no
(yes or no)

(organization running log)
(8) how well bottom plugged wash valve

DRILLERS REMARKS:


CODED

MISS. Bd. of
WATER COMMISSIONERS

MISS. Bd. of
WATER COMMISSIONERS

If well telescopes please sketch and show depths.

GROUND LEVEL

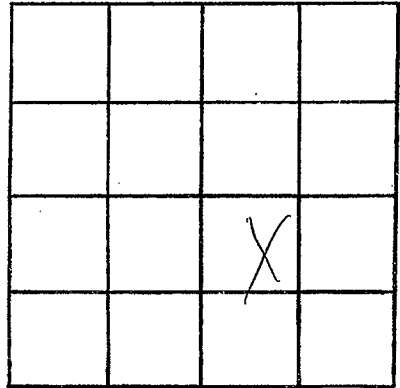

SECTION 22

Please indicate well location X.

ADDITIONAL INFORMATION

If more than one screen, show locations of each on sketch.