

Wayne
 R 27
 11-15-68

MISSISSIPPI
 BOARD OF WATER COMMISSIONERS
 416 North State Street
 Jackson, Mississippi 39201

CODED

WATER WELL DRILLERS LOG

11-15-1968 date well completed
 Ray West firm name
 Wayne county well located

LANDOWNER: J. M. Clark
 Rt 1
 Waynesboro
 (mailing address)

description of formations encountered	from	to
Sandy Clay	0	20
Clay	20	70
sand	70	125
Clay	125	225
rocky	225	230
clay and thin layers	230	303
rock and clay	303	350

WELL LOCATION:
 sec 36 T 9 N R 9 E
 15 miles East of Laurel
 (distance) (direction) (nearest town)

WELL PURPOSE: home
 (home, irrigation, municipal, industrial)

WELL COMPLETION DATA:

(1) diameter (inches) 2 in
 (2) total depth (feet) 350
 (3) static water level (feet) 90 below top of ground.
 (4) casing Galv. 325 (material) (depth)
 If telescope see back.
 (size)
 (5) screen \emptyset (length) (depth to top)
 (size) (material)
 (6) pump 1 (HP) 6 (yield gpm)
 Rea (type power)
 (7) electric log NO (yes or no)
 (organization running log)
 (8) how well bottom plugged Not plugged

CODED


DEC 22 1968

MISS. DE. OF WATER CONTROL

DRILLERS REMARKS:

If well telescopes please sketch and show depths.

GROUND LEVEL

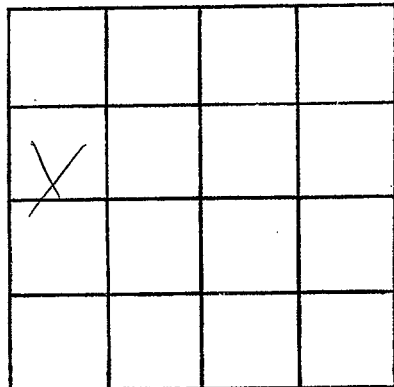

SECTION 36

Please indicate well location X.

ADDITIONAL INFORMATION

If more than one screen, show locations of each on sketch.