

Wayne
728.
8-14-68

MISSISSIPPI
BOARD OF WATER COMMISSIONERS
416 North State Street
Jackson, Mississippi 39201

CODED

WATER WELL DRILLERS LOG

8 14 1968 Ray U. West Wayne
date well completed firm name county well located

LANDOWNER: Bernie Walters
Rt 1
Laurel Miss
(mailing address)


description of formations encountered	from	to
<u>Sandy Clay</u>	<u>0</u>	<u>20</u>
<u>Sandy Clay</u>	<u>20</u>	<u>55</u>
<u>Soil</u>	<u>55</u>	<u>70</u>

WELL LOCATION:
sec. 32 9 N. R. 9 E
14 miles East of Laurel
(distance) (direction) (nearest town)

WELL PURPOSE: home
(home, irrigation, municipal, industrial)

- WELL COMPLETION DATA:
- (1) diameter (inches) 2
 - (2) total depth (feet) 70
 - (3) static water level (feet) 35 below above top of ground.
 - (4) casing plastic, 70
(material) (depth)
 - 2 if telescope see back.
(size)
 - (5) screen 5, 65
(length) (depth to top)
1/4, Stainless steel
(size) (material)
 - (6) pump 1, 10
(HP) (yield gpm)
RCA
(type power)
 - (7) electric log NO
(yes or no)
 - (8) how well bottom plugged wash valve


CODED

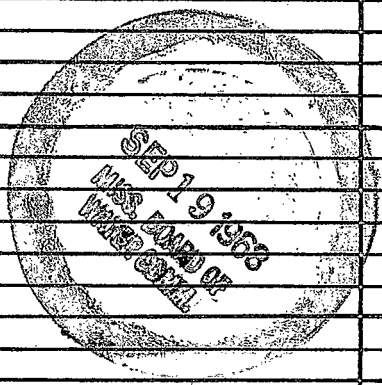

DRILLERS REMARKS:

If well telescopes please sketch and show depths.

GROUND LEVEL

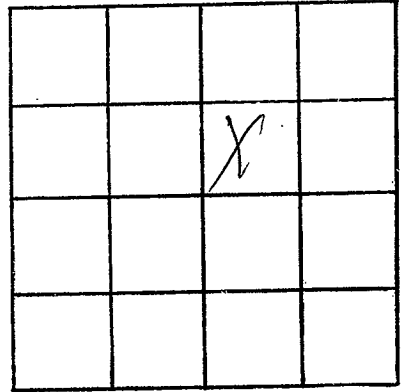

SECTION 32

Please indicate well location X.

ADDITIONAL INFORMATION

If more than one screen, show locations of each on sketch.