

Wayne
 7-29
 11-29-68

MISSISSIPPI
 BOARD OF WATER COMMISSIONERS
 416 North State Street
 Jackson, Mississippi 39201

CODED

WATER WELL DRILLERS LOG

11-29-68 1968 Royk West Wayne
 date well completed firm name county well located

LANDOWNER: <u>George Dingle</u> <u>RT 1</u> <u>Laurel Miss</u> (mailing address)	Description of formations encountered	from	to
		<u>Clay</u>	<u>0</u>
	<u>Sandy clay</u>	<u>8</u>	<u>35</u>
	<u>rock</u>	<u>35</u>	<u>71</u>

WELL LOCATION:
 sec 22 T 9 N R 9 E
18 miles E of Laurel
 (distance) (direction) (nearest town)

WELL PURPOSE: home
 (home, irrigation, municipal, industrial)

- WELL COMPLETION DATA:
- diameter (inches) 2
 - total depth (feet) 71
 - static water level (feet) 40 below top of ground.
 - casing galv 66
 (material) (depth)
 - screen 6 65
 (length) (depth to top)
 - pump 1 5
 (HP) (yield gpm)
 - electric log no
 (yes or no)
 - how well bottom plugged wash water

CODED


DRILLERS REMARKS:

NOV - 6 1968

MISS. BD. OF
 WATER COM.

If well telescopes please sketch and show depths.

GROUND LEVEL

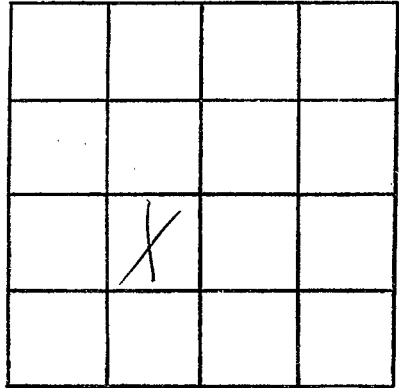

SECTION 22

Please indicate well location X.

ADDITIONAL INFORMATION

If more than one screen, show locations of each on sketch.