

Wayne
F31
6-69

MISSISSIPPI
BOARD OF WATER COMMISSIONERS
416 North State Street
Jackson, Mississippi 39201

CODED

WATER WELL DRILLERS LOG

10-16 date well completed 1969 firm name Rayl W est water wells county well located Wayne

LANDOWNER: H. M. Lindsey
Laurel Miss
(mailing address)

WELL LOCATION:
sec. 19 T. 9 N. R. 9 E
15 miles E of Laurel
(distance) (direction) (nearest town)

WELL PURPOSE: Farm
(home, irrigation, municipal, industrial)

- WELL COMPLETION DATA:
- (1) diameter (inches) 4 in
 - (2) total depth (feet) 118
 - (3) static water level (feet) 40 below above top of ground.
 - (4) casing plastic 100 (material) (depth)
4 in (size) if telescope see back.
 - (5) screen 15 ft 103 (length) (depth to top)
3 in St steel (size) (material)
 - (6) pump 3 78 (HP) (yield gpm)
R.E.A. (type power)
 - (7) electric log NO (yes or no)
 - (organization running log)
 - (8) how well bottom plugged Washwater

description of formations encountered	depth	
	from	to
Clay	0	10
Sand	10	25
Sandy Clay	25	40
Sand	40	80
Blue clay	80	95
Sand	95	118


DRILLERS REMARKS:

1 2 1969

MISS. Bd. of WATER COMMISSIONERS

If well telescopes please sketch and show depths.

GROUND LEVEL

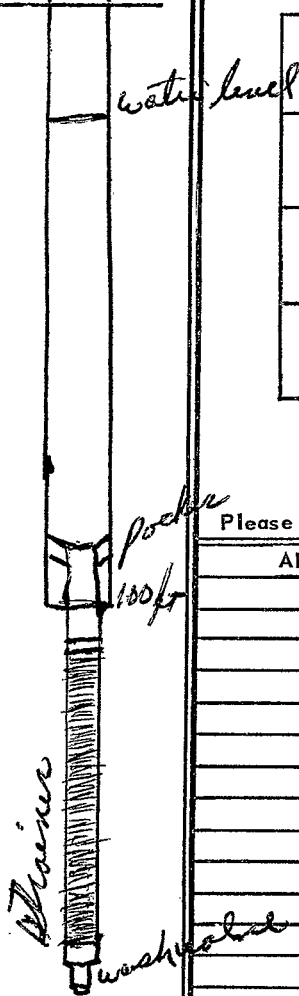

			X

SECTION 19

Please indicate well location X.

ADDITIONAL INFORMATION

If more than one screen, show locations of each on sketch.