

Wayne
F 32
9-22-69

MISSISSIPPI
BOARD OF WATER COMMISSIONERS
416 North State Street
Jackson, Mississippi 39201

CODED.

CODED.

WATER WELL DRILLERS LOG

9 22 1969 date well completed
Roy W. Stewart firm name
Wayne county well located

LANDOWNER: Charles Cooley
Rt 1 Waynesboro (mailing address)

description of formations encountered	from	to
	Red Clay	0
Clay	10	28
sandy clay	28	50
Clay	50	55
sand	55	72

WELL LOCATION:
sec 35 T 9 N R 9 E S W
12 miles west of Waynesboro
(distance) (direction) (nearest town)

WELL PURPOSE: home
(home, irrigation, municipal, industrial)


- WELL COMPLETION DATA:
- diameter (inches) 2 in
 - total depth (feet) 72
 - static water level (feet) 40 below top of ground.
 - casing galv 67 (material) (depth)
 - screen 5 ft 67 (length) (depth to top)
1/4" St Steel (size) (material)
 - pump 3/4 HP 9 (yield gpm)
R&A (type power)
 - electric log No (yes or no)
 - how well bottom plugged Washed (organization running log)

OCT 15 1969
MISS. BD. OF WATER COMMISSIONERS

DRILLERS REMARKS:

If well telescopes please sketch and show depths.

GROUND LEVEL

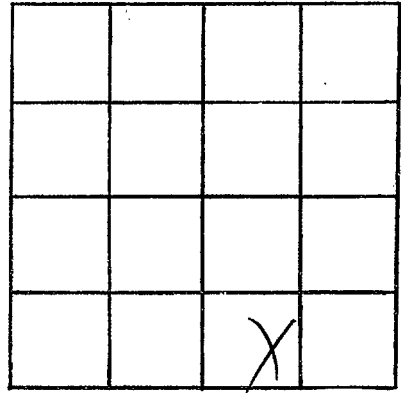

SECTION 35

Please indicate well location X.

ADDITIONAL INFORMATION

If more than one screen,
show locations of each on sketch.