

Wayne
733
9-11-69

MISSISSIPPI
BOARD OF WATER COMMISSIONERS
416 North State Street
Jackson, Mississippi 39201

CODED

CODED

WATER WELL DRILLERS LOG


9.11.1969 date well completed
Cag Royl Water Well Co firm name
Wayne county well located

LANDOWNER: <u>Jack Prince</u> <u>Rt 6 Box 263</u> <u>Laurel Miss</u> (mailing address)	description of formations encountered	from	to
	<u>Clay</u>	<u>0</u>	<u>6</u>
	<u>Sand</u>	<u>6</u>	<u>25</u>
	<u>Clay</u>	<u>25</u>	<u>45</u>
	<u>Sand</u>	<u>45</u>	<u>75</u>
WELL LOCATION:			
sec. <u>30</u> T <u>9</u> N R <u>9</u> E S W			
<u>1.4</u> miles <u>E</u> of <u>Laurel Miss</u> (distance) (direction) (nearest town)			
WELL PURPOSE: <u>Home</u> (home, irrigation, municipal, industrial)			
WELL COMPLETION DATA:			
(1) diameter (inches) <u>2</u>			
(2) total depth (feet) <u>75</u>			
(3) static water level (feet) <u>39</u> below above top of ground.			
(4) casing <u>plastic 70</u> (material) (depth)			
(size) if telescope see back.			
(5) screen <u>5 ft 70</u> (length) (depth to top)			
<u>1/4</u> <u>st steel</u> (size) (material)			
(6) pump <u>1</u> <u>12</u> (HP) (yield gpm)			
<u>REA</u> (type power)			
(7) electric log <u>no</u> (yes or no)			
(organization running log)			
(8) how well bottom plugged <u>washed</u>			
DRILLERS REMARKS:			

SEP 15 1969
MISSISSIPPI
BOARD OF WATER COMMISSIONERS

If well telescopes please sketch and show depths.

GROUND LEVEL

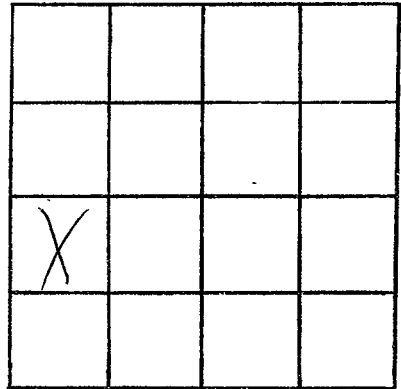

SECTION 30

Please indicate well location X.

ADDITIONAL INFORMATION

If more than one screen,
show locations of each on sketch.