

Wayne
7 34
12-3-69

MISSISSIPPI
BOARD OF WATER COMMISSIONERS
416 North State Street
Jackson, Mississippi 39201

CODED
CODED

WATER WELL DRILLERS LOG

12.3 1969 Ray W Westwater wells wayne
date well completed firm name county well located

LANDOWNERS	Description of formations encountered	from	to
John Lee McMillan Rt. 1	red clay	0	10
Shubuta Miss	clay	10	85
(mailing address)	some clay	85	105
	clay	105	135
	solid	135	148

WELL LOCATION:
sec. 13 T 9 N R 9 E
15 miles East Laurel
(distance) (direction) (nearest town)

WELL PURPOSE: home
(home, irrigation, municipal, industrial)

- WELL COMPLETION DATA:
- (1) diameter (inches) 2
 - (2) total depth (feet) 148
 - (3) static water level (feet) 85 below top of ground.
 - (4) casing galv (material) 143 (depth)
 - (size) if telescope see back.
 - (5) screen 5 ft 143 (length) (depth to top)
 - 1 1/2 (size) stainless steel (material)
 - (6) pump 1 hp 6 (HP) (yield gpm)
 - Rca (type power)
 - (7) electric log No (yes or no)


(organization running log)
(8) how well bottom plugged washed

JAN 26 1970

DRILLERS REMARKS:
MISS. BD. OF WATER COM.

If well telescopes please sketch and show depths.

GROUND LEVEL

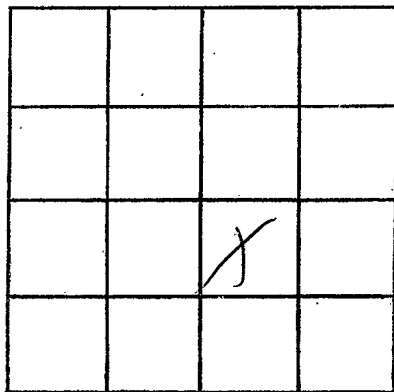

SECTION 13

Please indicate well location X.

ADDITIONAL INFORMATION

If more than one screen,
show locations of each on sketch.