

Wayne
F 35
2-17-70

MISSISSIPPI
BOARD OF WATER COMMISSIONERS
416 North State Street
Jackson, Mississippi 39201

WATER WELL DRILLERS LOG

INDEXED

2-17-70 date well completed 1970 firm name Royal Westwater county well located Wayne

LANDOWNER	description of formations encountered	from	to
John Worren Rt 1 Laurel Miss	Sandy clay Sand	0	8 55

(mailing address)

WELL LOCATION:
sec 32 T 9 N R 9 E
18 miles S of Laurel
(distance) (direction) (nearest town)

WELL PURPOSE: home
(home, irrigation, municipal, industrial)

WELL COMPLETION DATA:

- (1) diameter (inches) 2
- (2) total depth (feet) 55
- (3) static water level (feet) 21 below top of ground.
- (4) casing plastic 50
(material) (depth)
- (size) If telescope see back.
- (5) screen 5 ft 50
(length) (depth to top)
- 1 1/2 St Steel
(size) (material)
- (6) pump 1 1/2 12
(HP) (yield gpm)
- REA
(type power)
- (7) electric log NO
(yes or no)

(organization running log)

(8) how well bottom plugged Wash hole


FEB 27 1970

DRILLERS REMARKS:

MISS. BD. OF
WATER COMM.

If well telescopes please sketch and show depths.

GROUND LEVEL

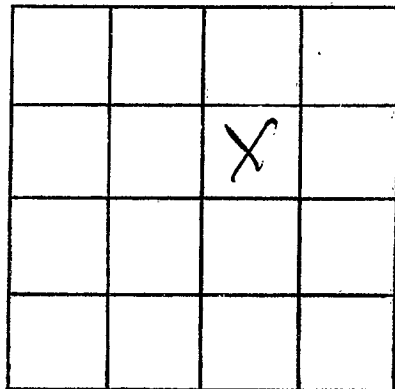

SECTION 32

Please indicate well location X.

ADDITIONAL INFORMATION

If more than one screen,
show locations of each on sketch.