

Wayne
F37
3-1-70

MISSISSIPPI
BOARD OF WATER COMMISSIONERS
416 North State Street
Jackson, Mississippi 39201

CODED

WATER WELL DRILLERS LOG

3-1 1970 Roy U Westcott & Wayne
date well completed firm name county well located

LANDOWNER: Robert Clark
description of formations encountered
from to
Clay 0 10
sandy clay 10 30
sand 30 74
RT 1 Waynesboro (mailing address)

WELL LOCATION:
sec. 39 T 9 N R 9 E
12 miles W of Waynesboro
(distance) (direction) (nearest town)

WELL PURPOSE: home
(home, irrigation, municipal, industrial)

WELL COMPLETION DATA:
(1) diameter (inches) 2
(2) total depth (feet) 74
(3) static water level (feet) 34 below top of ground.
(4) casing galv 69 (material) (depth)
(size) if telescope see back.
(5) screen 5ft 69 (length) (depth to top)
14 St steel (size) (material)
(6) pump 1 9 (HP) (yield gpm)
Rea (type power)
(7) electric log NO (yes or no)

CODED


(organization running log)
(8) how well bottom plugged cerashed
APR - 7 1970

DRILLERS REMARKS:

MISS. BD. OF
WATER COMM.

If well telescopes please sketch and show depths.

GROUND LEVEL

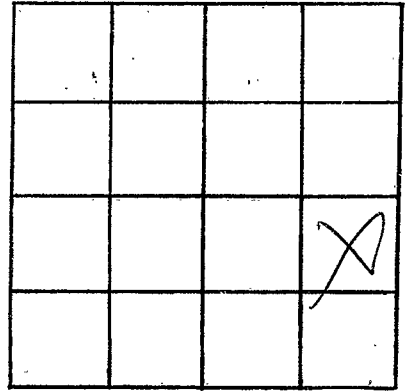

SECTION 39

Please indicate well location X.

ADDITIONAL INFORMATION

If more than one screen,
show locations of each on sketch.