

MISSISSIPPI BOARD OF WATER COMMISSIONERS

Wayne
F 46

6-29-63

WATER WELL DRILLERS LOG

Date: 6/29, 1963, Driller: E.P. Clark County Wayne
(Name)

CODED

Correct
7/24/69 JMC
Wayne

(1) Owner of Land: <u>Floyd McDonald</u> <small>(Name)</small>	Description & Color of Materials Sand, Clay, Red Clay, Shell, etc.	Thick- ness Feet	Depth Feet
<u>Rt #1 Shelbourn Miss</u> <small>(Address)</small>	<u>0-35 red clay</u>	<u>35</u>	
(2) Location: <u>15 9N 9W</u> <u>1.6 miles East</u> of <u>Sauel</u> <small>(distance) (direction) (Nearest Town)</small>	<u>35-75 sand</u>	<u>40</u>	
(3) Topography: <input checked="" type="checkbox"/> (Hilly) <input type="checkbox"/> (Flat) <input type="checkbox"/> (Level)			
(4) Purpose of Well: <input type="checkbox"/> Domestic Irrigation <input type="checkbox"/> Municipal, Industrial, Other			

Information upon completion of well:


- (1) Diameter 2 inches.
- (2) Total Depth 75 feet.
- (3) Water Level 40 feet below top of ground.
- (4) Cased to 65, Size 2
- (5) Screen: Size 1 1/4, Length 10
- (6) Were any formations sealed against pollution?
 yes, no.

If YES depth of formation _____

Why _____

Drillers Remarks: _____

CODED

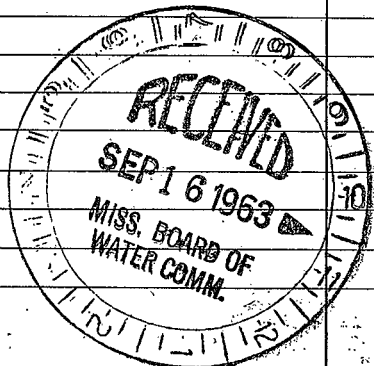

(Use Back Side)

Well No.

