

Wayne
F 43
4-20-70

MISSISSIPPI
BOARD OF WATER COMMISSIONERS
416 North State Street
Jackson, Mississippi 39201

WATER WELL DRILLERS LOG

April 20 1970 Robert Clark, Wayne
(date well completed) (firm name) (county well located)

LANDOWNER: Robert Clark
801 Charles Dr
Thurgood Marshall Miss
(mailing/address)

WELL LOCATION:
sec 36 T 7 S R 7 E 033
1 miles N of Thurgood Marshall
(distance) (direction) (nearest town)

WELL PURPOSE: Home
(home, irrigation, municipal, industrial)

WELL COMPLETION DATA:

(1) diameter (inches) 2"
(2) total depth (feet) 77'
(3) static water level (feet) 42' below top of ground.
(4) casing (material) steel (depth) 70'
(size) 2" If telescope see back.
(5) screen (length) 2' (depth to top) 70'
(size) (material)
(6) pump 3/4 (HP) 9 (yield gpm)
(type power) elec
(7) electric log (yes or no)
(organization running log)
(8) how well bottom plugged

description of formations encountered	from	to
Clay	0	10
work sandstone	10	33
blue chalk	33	45
blue sand	45	57
blue chalk	57	70
blue sandstone	70	97
63' 1 1/2" clay pipe		
casing sealed off		
top of rock work		
lining & cement		


MAY 20 1970

MISS. BD. OF
WATER COMMISSIONERS

DRILLERS REMARKS:

If well telescopes please sketch and show depths.

GROUND LEVEL

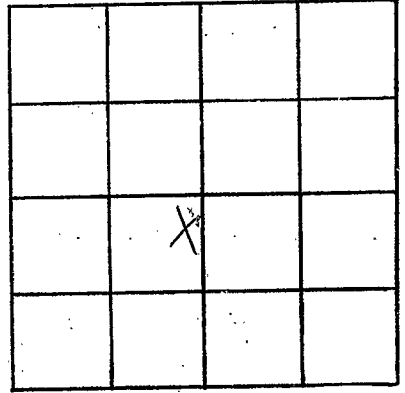

SECTION 26

Please indicate well location X.

ADDITIONAL INFORMATION

If more than one screen,
show locations of each on sketch.