

WAYNE
F46
8-1-70

MISSISSIPPI
BOARD OF WATER COMMISSIONERS
416 North State Street
Jackson, Mississippi 39201

CODED

WATER WELL DRILLERS LOG

Aug 1 1970 Roy O West Waterwells Wayne
date well completed firm name county well located

LANDOWNER: Almer Pope
Rt 1 Laurel Miss
(mailing address)

description of formations encountered	from	to
Clay	0	15
sandy clay	15	38
Clay	38	80
sandy clay	80	110
sand	110	165
Clay	165	227
sandy clay	227	252
rock	252	255
sand	255	265
blue clay	265	303
rock	303	304
dk rock and clay	304	350

WELL LOCATION:
sec. 29 T 9 N R. 9 E
12 miles E of Laurel
(distance) (direction) (nearest town)

WELL PURPOSE: home
(home, irrigation, municipal, industrial)

WELL COMPLETION DATA:

(1) diameter (inches) 2

(2) total depth (feet) 350

(3) static water level (feet) 80 below top of ground.

(4) casing galv 315
(material) (depth)
(size) If telescope see back.

(5) screen 0
(length) (depth to top)
0 0
(size) (material)

(6) pump 1 6
(HP) (yield gpm)
REA
(type power)

(7) electric log no
(yes or no)

(organization running log)


(8) how well bottom plugged _____

CODED

DRILLERS REMARKS:

If well telescopes please sketch and show depths.

GROUND LEVEL

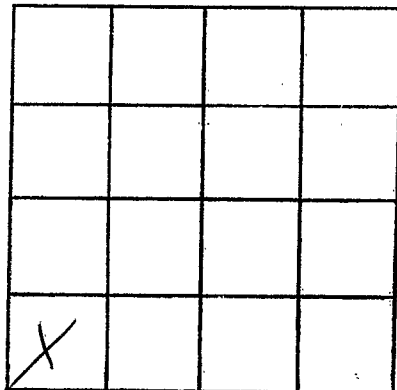

SECTION 29

Please indicate well location X.

ADDITIONAL INFORMATION

If more than one screen, show locations of each on sketch.

AUG 25 1970

MISS. Bd. OF

WATER CONTROL