

WAYNE
F49
3-11-71

MISSISSIPPI
BOARD OF WATER COMMISSIONERS
416 North State Street
Jackson, Mississippi 39201

CODED

WATER WELL DRILLERS LOG

Mar 11 1971 Roy U West Water Wells
date well completed firm name county well located

LANDOWNER: W. N. Clark
Rt 1
Waynesboro
(mailing address)

description of fomations encountered	from	to
<u>sandy clay</u>	<u>0</u>	<u>12</u>
<u>clay</u>	<u>12</u>	<u>35</u>
<u>sand</u>	<u>35</u>	<u>70</u>
<u>clay</u>	<u>70</u>	<u>73</u>
<u>sand</u>	<u>73</u>	<u>88</u>

WELL LOCATION:
sec. 36 T. 9 N. R. 9 E
15 miles E of Laud
(distance) (direction) (nearest town)

WELL PURPOSE: home
(home, irrigation, municipal, industrial)

WELL COMPLETION DATA:

(1) diameter (inches) 2

(2) total depth (feet) 88

(3) static water level (feet) 60 below above top of ground.

(4) casing galv 83
(material) (depth)

_____ if telescope see back.
(size)

(5) screen 5 83
(length) (depth to top)

1/4 St Steel
(size) (material)

(6) pump 1/2 8
(HP) (yield gpm)

R.E.A
(type power)

(7) electric log Yes
(yes or no)

CODED

(organization running log)

(8) how well bottom plugged wash hole


MAR 30 1971

MISS. BD. OF
WATER COM.

DRILLERS REMARKS:

If well telescopes please sketch and show depths.

GROUND LEVEL

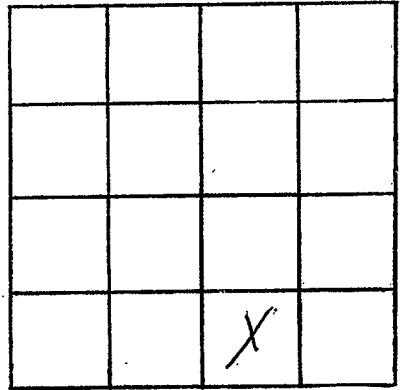

SECTION 36

Please indicate well location X.

ADDITIONAL INFORMATION

If more than one screen,
show locations of each on sketch.