

WAYNE  
F52  
5-17-71

MISSISSIPPI  
BOARD OF WATER COMMISSIONERS  
416 North State Street  
Jackson, Mississippi 39201

**CODED**

WATER WELL DRILLERS LOG

May 17 1971 Reyl W Water Well Wayne  
date well completed firm name county well located

LANDOWNER: Gronnie Sellers Rt 1 Laurel Miss  
(mailing address)

description of formations encountered	from	to
<u>sandy clay</u>	<u>0</u>	<u>10</u>
<u>sand</u>	<u>10</u>	<u>48</u>

WELL LOCATION:  
sec 34 T 9 N R 9 E  
14 miles E of Laurel Miss  
(distance) (direction) (nearest town)

WELL PURPOSE: check water  
(home, irrigation, municipal, industrial)

- WELL COMPLETION DATA:
- (1) diameter (inches) 4 in
  - (2) total depth (feet) 48
  - (3) static water level (feet) 20 below above top of ground.
  - (4) casing galv 43  
(material) (depth)
  - (size) if telescope see back.
  - (5) screen 5 43  
(length) (depth to top)
  - 4 in st steel  
(size) (material)
  - (6) pump 1 1/2 58  
(HP) (yield gpm)
  - Rea  
(type power)
  - (7) electric log no  
(yes or no)
  - (organization running log)
  - (8) how well bottom plugged wash water

**CODED**


JUL 6 1971

MISS. DEP. OF AGRIC. & MECHANICAL INDUSTRIES

DRILLERS REMARKS:

If well telescopes please sketch and show depths.

GROUND LEVEL

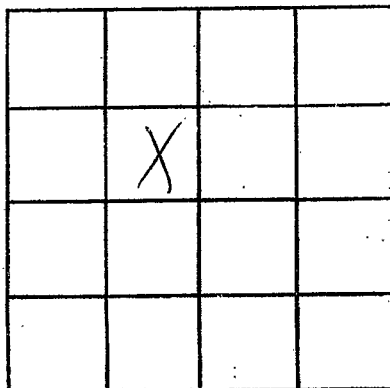

SECTION 34

Please indicate well location X.

ADDITIONAL INFORMATION

If more than one screen, show locations of each on sketch.