

**MISSISSIPPI
BOARD OF WATER COMMISSIONERS**
416 North State Street
Jackson, Mississippi 39201

CODED

WATER WELL DRILLERS LOG

WAYNE
F 53
5-29-71

May 29 1971 Regulation Water Wells Wayne
date well completed firm name county well located

LANDOWNER: W. G. Pryor
Rt 6
Laurel Miss
(mailing address)

description of formations encountered	from	to
Clay	0	12
sandy clay	12	45
clay	45	65
sandy clay	65	79
green clay	79	114
sand	114	135

WELL LOCATION:
sec. 18 T. 9 N. R. 9 E
8 miles S of Sodusville
(distance) (direction) (nearest town)

WELL PURPOSE: Chicken house
(home, irrigation, municipal, industrial)

- WELL COMPLETION DATA:
- (1) diameter (inches) 4 in
 - (2) total depth (feet) 135
 - (3) static water level (feet) 55 below/above top of ground.
 - (4) casing galv 120
(material) (depth)
 - _____ if telescope see back.
(size)
 - (5) screen 15 120
(length) (depth to top)
 - 2 in St Steel
(size) (material)
 - (6) pump 1/2 50
(HP) (yield gpm)
 - Rca
(type power)
 - (7) electric log no
(yes or no)
 - _____ (organization running log)
 - (8) how well bottom plugged capshave

CODED


JUL 6 1971

MISS. BDL. OF
WATER DRILLING

DRILLERS REMARKS:

If well telescopes please sketch and show depths.

GROUND LEVEL

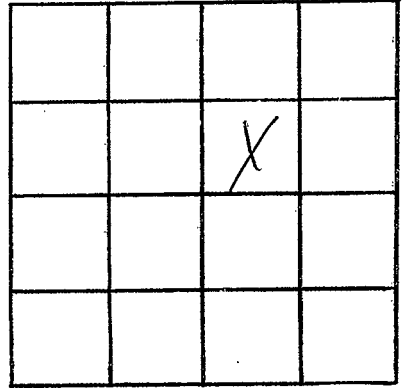

SECTION 18

Please indicate well location X.

ADDITIONAL INFORMATION

If more than one screen,
show locations of each on sketch.