

WAYNE
F 54
6-8-71

MISSISSIPPI
BOARD OF WATER COMMISSIONERS
416 North State Street
Jackson, Mississippi 39201

CODED

WATER WELL DRILLERS LOG

June 8 1971 Key West Water Wells Wayne
date well completed firm name county well located

LANDOWNER: <i>J. L. Purvis</i>	description of formations encountered	from	to
<i>Rt 6 Laurel Miss</i>			

(mailing address)

WELL LOCATION:

sec. *6* T *2* N R *9* E
8 miles *E* of *Sandersville*
(distance) (direction) (nearest town)

WELL PURPOSE: *check house*
(home, irrigation, municipal, industrial)

WELL COMPLETION DATA:

- (1) diameter (inches) *2 1/2*
- (2) total depth (feet) *34*
- (3) static water level (feet) *10* below/above top of ground.
- (4) casing *galv* *29*
(material) (depth)
- (5) screen *5 ft* *29*
(length) (depth to top)
1 1/2 *st steel*
(size) (material)
- (6) pump *1* *10*
(HP) (yield gpm)
Rea
(type power)
- (7) electric log *No*
(yes or no)

(organization running log)

(8) how well bottom plugged *wash water*

CODED


JUL 6 1971

MISS. ED. 05
STATE OF MISSISSIPPI

DRILLERS REMARKS:

If well telescopes please sketch and show depths.

GROUND LEVEL

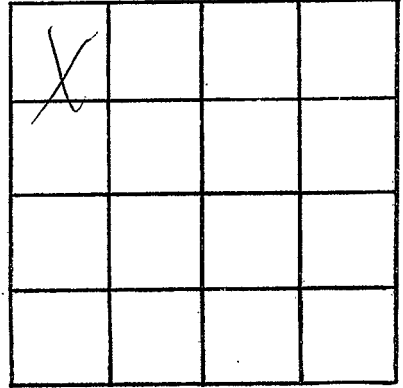

SECTION 2

Please indicate well location X.

ADDITIONAL INFORMATION

If more than one screen,
show locations of each on sketch.