

Wayne
F 60
10-15-71

MISSISSIPPI
BOARD OF WATER COMMISSIONERS
416 North State Street
Jackson, Mississippi 39201

DEC 9 1971

WATER WELL DRILLERS LOG

CODED

Oct 15 1971 Roy West Water Well Wayne
date well completed firm name county well located

LANDOWNER: Thad's Pryor
Rt 1 Laurel
Miss
(mailing address)

description of formations encountered	from	to
Clay	0	5
Roundy clay	5	20
sand	20	68

WELL LOCATION:
sec 28 T 9 N R 9 E
S W
16 miles W of Waynesboro
(distance) (direction) (nearest town)

WELL PURPOSE: Check house.
(home, irrigation, municipal, industrial)

- WELL COMPLETION DATA:
- (1) diameter (inches) 2 in
 - (2) total depth (feet) 68
 - (3) static water level (feet) 10 below top of ground.
 - (4) casing plastic, 63 (material) (depth)
 - (size) If telescope see back.
 - (5) screen 5 ft, 63 (length) (depth to top)
 - 1 1/4" St Steel (size) (material)
 - (6) pump 3/4 (HP) 12 (yield gpm)
 - Rea (type power)
 - (7) electric log NO (yes or no)


(organization running log)
(8) how well bottom plugged Wash valve

DRILLERS REMARKS:

CODED

If well telescopes please sketch and show depths.

GROUND LEVEL

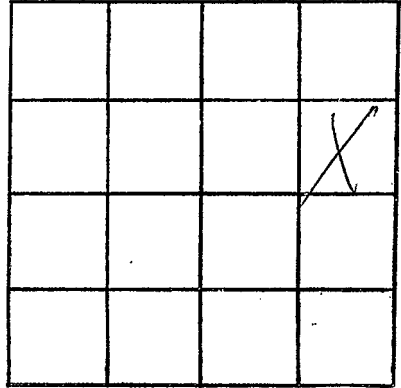

SECTION 28

Please indicate well location X.

ADDITIONAL INFORMATION

A series of horizontal lines for additional information.

If more than one screen, show locations of each on sketch.