

Wayne
F61
4-3-72

CODED MISSISSIPPI **C. P. CLARK**
BOARD OF WATER COMMISSIONERS **WELL DRILLING**
416 North State Street **ROUTE 2**
Jackson, Mississippi 39201 **MOUREL, MISS. 39440**

WATER WELL DRILLERS LOG

4/3 1972 C.P. Clark Wayne
date well completed firm name county well located

LANDOWNER:	description of formations encountered	from	to
<u>Jack Fleming</u> <u>Plt # 3</u>			
<u>Shubuta, Miss.</u> (mailing address)	<u>Sandy Clay</u>	<u>0</u>	<u>3</u>
	<u>White Clay</u>	<u>3</u>	<u>16</u>
	<u>Sand</u>	<u>16</u>	<u>31</u>
	<u>Mixed Sand & Clay</u>	<u>31</u>	<u>35</u>
	<u>Sand</u>	<u>35</u>	<u>48</u>
	<u>Mixed Sand & Clay</u>	<u>48</u>	<u>52</u>
	<u>Clay with Sand Shells</u>	<u>52</u>	<u>64</u>
	<u>Rock</u>	<u>64</u>	<u>64 1/2</u>
	<u>Blue Sand & Sea Shells</u>	<u>64 1/2</u>	<u>71</u>
	<u>Blue Clay</u>	<u>71</u>	<u>73</u>
WELL LOCATION:			
sec. <u>11</u> T. <u>9</u> S. R. <u>9</u> E.			
<u>5 1/2</u> miles <u>NW</u> of <u>Whittle</u>			
(distance) (direction) (nearest town)			
WELL PURPOSE:			
(home, irrigation, municipal, industrial)			
WELL COMPLETION DATA:			
(1) diameter (inches) <u>2</u>			
(2) total depth (feet) <u>71</u>			
(3) static water level (feet) <u>14</u> below top of ground.			
(4) casing <u>Galv. Iron</u> <u>66</u> (material) (depth)			
(size) if telescope see back.			
(5) screen <u>5</u> <u>66</u> (length) (depth to top)			
<u>1 1/4"</u> <u>Solid S.S.</u> (size) (material)			
(6) pump <u>3/4</u> <u>15</u> (HP) (yield gpm)			
<u>220V S.P.</u> (type power)			
(7) electric log <u>no</u> (yes or no)			
(organization running log)			
(8) how well bottom plugged <u>BwU</u>			
DRILLERS REMARKS: <u>Set 12A</u> <u>Get @ 42'</u>			


CODED

APR 26 1972

MISS. BD. OF
WATER COMMISSIONERS

If well telescopes please sketch and show depths.

GROUND LEVEL

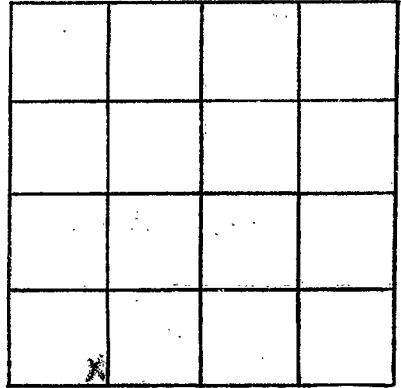

SECTION 01

Please indicate well location X.

ADDITIONAL INFORMATION

CODED

If more than one screen, show locations of each on sketch.