

WAYNE
F62
3-30-72

MISSISSIPPI
 BOARD OF WATER COMMISSIONERS
 416 North State Street
 Jackson, Mississippi 39201

WATER WELL DRILLERS LOG

CODED

3-30-72 1981 R GREEN WATER WELL WAYNE CO.
 date well completed firm name county well located

LANDOWNER: Wayne Varner
Route 6 Laurel min
Box 284 39440
 (mailing address)

description of formations encountered	from	to
Yellow Chalk	0	10
" "	10	20
" "	20	28
Fine sand	28	30
Blue Chalk	30	38
Water sand	38	40
" "	40	45
Blue Chalk	45	

WELL LOCATION:
 sec 16 T 9 N R 9 W
10 miles (distance) miles East (direction) of Sandrovill (nearest town)

WELL PURPOSE:
 (home, irrigation, municipal, industrial)

- WELL COMPLETION DATA:
- (1) diameter (inches) 4
 - (2) total depth (feet) 45
 - (3) static water level (feet) 15 below above top of ground.
 - (4) casing P.V.C. 40
 (material) (depth)
 - _____ if telescope see back.
 (size)
 - (5) screen 50" 40
 (length) (depth to top)
2" .006 PVC
 (size) (material)
 - (6) pump 3/4 SET _____
 (HP) (yield gpm)
110 V. A.C.
 (type power)
 - (7) electric log NO
 (yes or no)
 - _____ (organization running log)
 - (8) how well bottom plugged _____

CODED


APR 28 1972

MISS. BO. W. C.
 MISSISSIPPI BOARD OF WATER COMMISSIONERS

DRILLERS REMARKS:

If well telescopes please sketch and show depths.

GROUND LEVEL

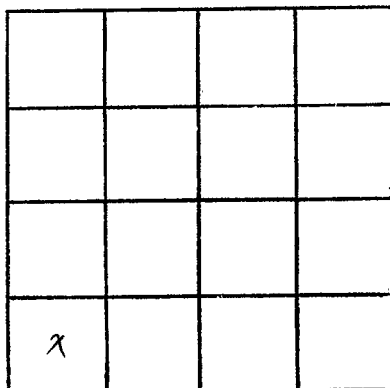

SW of SW SEC 16

SECTION 16

Please indicate well location X.

ADDITIONAL INFORMATION

If more than one screen,
show locations of each on sketch.