

Wayne
F63
4-6-72

MISSISSIPPI
BOARD OF WATER COMMISSIONERS
416 North State Street
Jackson, Mississippi 39201

WATER WELL DRILLERS LOG

CODED

April 6 1972 Prop/West Hester Lake Wayne
date well completed firm name county well located

LANDOWNER: Bill Baker
Bobby Wayne Kesterson
(mailing address)

| description of formations encountered | from | to |
|---------------------------------------|------|----|
| Sandy Clay | 0 | 35 |
| Clay | 35 | 50 |
| Sand | 50 | 75 |

WELL LOCATION:
sec. 11 T. 9 N. R. 9 E
12 miles E of Hillsboro
(distance) (direction) (nearest town)

WELL PURPOSE: Chicken house
(home, irrigation, municipal, industrial)

- WELL COMPLETION DATA:
- (1) diameter (inches) 2 in
 - (2) total depth (feet) 76
 - (3) static water level (feet) 40 below top of ground.
 - (4) casing galv 71 (material) (depth)
 - (size) if telescope see back.
 - (5) screen 5 71 (length) (depth to top)
 - 1/2" steel (size) (material)
 - (6) pump 1/2 (HP) 5 (yield gpm)
 - IRGA (type power)
 - (7) electric log NO (yes or no)
 - (organization running log)
 - (8) how well bottom plugged Washwater

CODED


MAY 2 - 1972

MISS. DD. 05
JAN 1972

DRILLERS REMARKS:

If well telescopes please sketch and show depths.

GROUND LEVEL

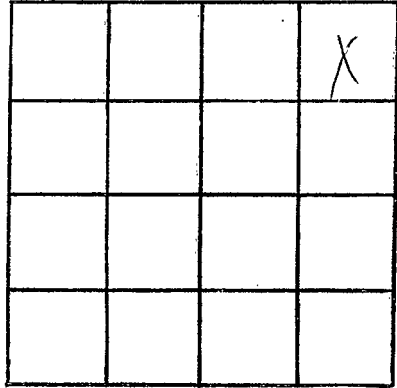

SECTION 12

Please indicate well location X.

ADDITIONAL INFORMATION

If more than one screen,
show locations of each on sketch.