

WAYNE
F 64
7-18-72

MISSISSIPPI
 BOARD OF WATER COMMISSIONERS
 416 North State Street
 Jackson, Mississippi 39201

WATER WELL DRILLERS LOG
 CLANTON + McILWAIN

CODED

July 18 1972 WATER Well SER. WAYNE
 date well completed firm name county well located

LANDOWNER:	description of formations encountered	from	to
Bill Baker			
Box 624 WAYNESBORO, Miss. (mailing address)	GREY CHALK	10	20
	RED, PINK + GREY CHALK	20	38
	SAND	38	58
	GREY CHALK	58	60
	SAND	60	70
	BROWN + GREY CHALK	70	75
	SAND	75	98
	CHALK	98	—
WELL LOCATION:			
sec. 2 T. 9 N R. 9 W			
16 miles NW of W'BORO			
(distance) (direction) (nearest town)			
WELL PURPOSE: HOME (home, irrigation, municipal, industrial)			
WELL COMPLETION DATA:			
(1) diameter (inches) 2"			
(2) total depth (feet) 98'			
(3) static water level (feet) 48' below top of ground			
(4) casing PVC 94' (material) (depth)			
2" (size) If telescope see back.			
(5) screen 5' 93' (length) (depth to top)			
2" (size) PVC (material)			
(6) pump 1 (HP) 5.5 (yield gpm)			
220 AC (type power)			
(7) electric log NO (yes or no)			
(organization running log)			
(8) how well bottom plugged B.W. VALVE.			
DRILLERS REMARKS:			


CODED

AUG 10 1972

MISS. BD. OF WATER COMM.

If well telescopes please sketch and show depths.

GROUND LEVEL

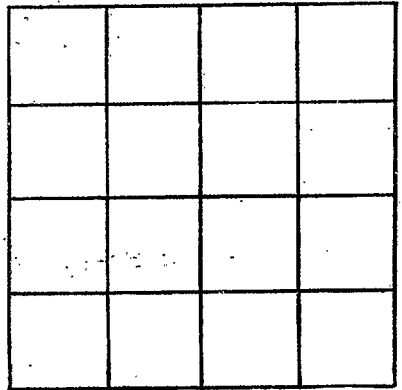

SECTION _____

Please indicate well location X.

ADDITIONAL INFORMATION

If more than one screen, show locations of each on sketch.