

MISSISSIPPI
 BOARD OF WATER COMMISSIONERS
 416 North State Street
 Jackson, Mississippi 39201

CODED

WATER WELL DRILLERS LOG

CHARTON & McILWAIN

1972 WATER WELL SER.

WAYNE

WAYNE
 F 65
 8-1-72

Aug 1
 date well completed

1972
 firm name

county well located

LANDOWNER:
 LEE DOUGLAS
 Rt WAYNESBORD, MISS.
 (mailing address)

description of formations encountered	from	to
SANDY CLAY	0	7
BLUE CLAY	7	18
SAND	18	35

WELL LOCATION:
 sec. 36 T 9 N R 9 E
 13 miles W of WAYNESBORD
 (distance) (direction) (nearest town)

WELL PURPOSE: HOME
 (home, irrigation, municipal, industrial)

- WELL COMPLETION DATA:
- (1) diameter (inches) 2"
 - (2) total depth (feet) 35 FEET
 - (3) static water level (feet) 20' below top of ground.
 - (4) casing PVC 29'
 (material) (depth)
2" If telescope see back.
 (size)
 - (5) screen 6' 29'
 (length) (depth to top)
1/4" PVC .009
 (size) (material)
 - (6) pump 1 8.5
 (HP) (yield gpm)
110 AC
 (type power)
 - (7) electric log NO
 (yes or no)
- (organization running log)
- (8) how well bottom plugged

CODED


AUG 16 1972

MISS. BD. OF
 WATER COMMISSIONERS

DRILLERS REMARKS:

If well telescopes please sketch and show depths.

GROUND LEVEL

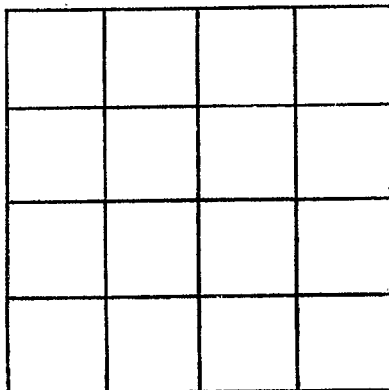

SECTION _____

Please indicate well location X.

ADDITIONAL INFORMATION

If more than one screen, show locations of each on sketch.