

WAYNE  
F67  
9-25-72

MISSISSIPPI  
BOARD OF WATER COMMISSIONERS  
416 North State Street  
Jackson, Mississippi 39201

**CODED**

WATER WELL DRILLERS LOG

Sept 25 1972 Ray Westwater wells WAYNE  
days well completed firm name county well located

LANDOWNER: <u>Austin Browder</u>	description of formations encountered	from	to
(mailing address)			
<u>Rt 6 Box 289 Laurel</u>	<u>Clay</u>	<u>0</u>	<u>15</u>
	<u>Sandy clay</u>	<u>15</u>	<u>28</u>
	<u>Clay</u>	<u>28</u>	<u>45</u>
	<u>Sand</u>	<u>45</u>	<u>68</u>

WELL LOCATION:  
sec. 7 T. 9 S. R. 9 E.  
8 miles E of Sondusville  
(distance) (direction) (nearest town)

WELL PURPOSE: home  
(home, irrigation, municipal, industrial)

- WELL COMPLETION DATA:
- (1) diameter (inches) 2 in
  - (2) total depth (feet) 68
  - (3) static water level (feet) 35 below/above top of ground.
  - (4) casing galv 63  
(material) (depth)  
(size) if telescope see back.
  - (5) screen 5 63  
(length) (depth to top)  
1/4 St Steel  
(size) (material)
  - (6) pump 1/2 (HP) 4 (yield gpm)  
R.E.A.  
(type power)
  - (7) electric log no  
(yes or no)
  - (organization running log)
  - (8) how well bottom plugged unshaken

**CODED**


OCT 12 1972

DRILLERS REMARKS:

MISSISSIPPI BOARD OF WATER COMMISSIONERS  
STATE OF MISSISSIPPI

If well telescopes please sketch and show depths.

GROUND LEVEL

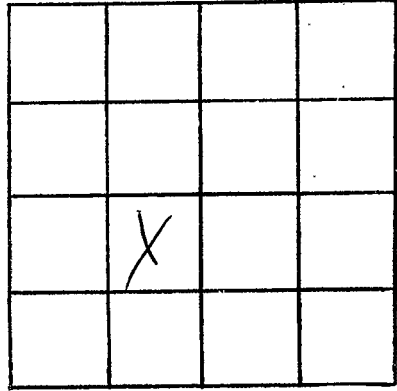

SECTION 7

Please indicate well location X.

ADDITIONAL INFORMATION

---

---

If more than one screen, show locations of each on sketch.