

WAYNE  
F68  
11-14-72

MISSISSIPPI  
BOARD OF WATER COMMISSIONERS  
416 North State Street  
Jackson, Mississippi 39201

WATER WELL DRILLERS LOG **CODED**

11-14-72 date well completed      JR GREEN WATERWELL firm name      WAYNE county well located

LANDOWNER:	description of formations encountered	from	to
W.A. GREEN	SAND	0	10
SHUBUTA RD 3 BOX 95 MISS (mailing address)	11	10	20
	11	20	30
	11	30	32

WELL LOCATION:  
sec. 3 T. 9 N R. 9 W  
S W  
3 miles SOUTH of EUCUTTA  
(distance) (direction) (nearest town)

WELL PURPOSE: HOME  
(home, irrigation, municipal, industrial)

- WELL COMPLETION DATA:
- (1) diameter (inches) 4
  - (2) total depth (feet) 32
  - (3) static water level (feet) 16 below above top of ground.
  - (4) casing PVC 27  
(material) (depth)  
(size) if telescope see back.
  - (5) screen 5' 27  
(length) (depth to top)  
2 1008 PVC  
(size) (material)
  - (6) pump PITCHER  
(HP) (yield gpm)  
(type power)
  - (7) electric log NO  
(yes or no)
  - (organization running log)

**CODED**

DEC 6 1972


MISS. Bd. OF  
WATER COMMISSIONERS

(8) how well bottom plugged \_\_\_\_\_

DRILLERS REMARKS: \_\_\_\_\_

If well telescopes please  
sketch and show depths.

GROUND LEVEL

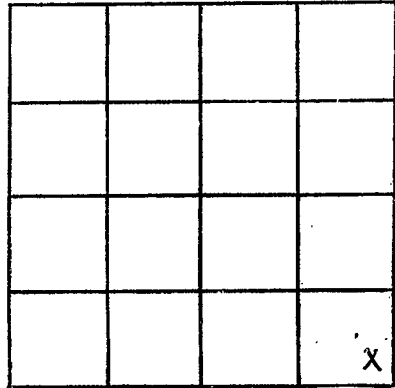

SE  $\frac{1}{4}$  OF SE  $\frac{1}{4}$

SECTION 3

Please indicate well location X.

ADDITIONAL INFORMATION

If more than one screen,  
show locations of each on sketch.