

MISSISSIPPI
BOARD OF WATER COMMISSIONERS
416 North State Street
Jackson, Mississippi 39201

CODED

WATER WELL DRILLERS LOG

Wayne
F 69
12-4-72

Dec 4 1972 Roy West water wells Wayne
date well completed firm name county well located

LANDOWNER: Waldon Reenes
Hellburg Rt 2 Box 221
(mailing address)

WELL LOCATION:
sec. 6 T. 9 N. R. 9 E
8 miles E of Southernville
(distance) (direction) (nearest town)

WELL PURPOSE: home
(home, irrigation, municipal, industrial)

- WELL COMPLETION DATA:
- (1) diameter (inches) 2 in
 - (2) total depth (feet) 250
 - (3) static water level (feet) 90 below above top of ground.
 - (4) casing galv 173
(material) (depth)
(size) if telescope see back.
 - (5) screen 0
(length) (depth to top)
(size) (material)
 - (6) pump 1 7
(HP) (yield gpm)
PEA
(type power)
 - (7) electric log no
(yes or no)
(organization running log)
 - (8) how well bottom plugged open bottom

description of formations encountered	from	to
clay	0	3
sand	3	28
clay	28	65
sandy clay	65	85
blk clay	85	165
lime rock strata	165	180
clay	180	250


JAN 24 1973

MISS. Bd. OF
WATER COM.

DRILLERS REMARKS:

If well telescopes please sketch and show depths.

GROUND LEVEL

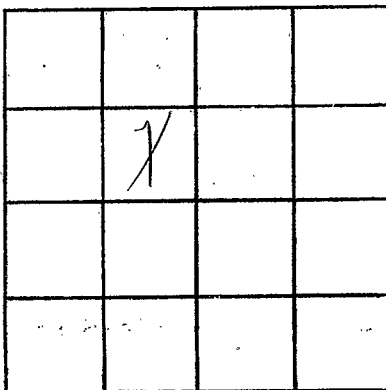

SECTION 6

Please indicate well location X.

ADDITIONAL INFORMATION

If more than one screen,
show locations of each on sketch.