

WAYNE

F 74

2-7-73

MISSISSIPPI BOARD OF WATER COMMISSIONERS 416 North State Street Jackson, Mississippi 39201

WATER WELL DRILLERS LOG

Feb 7

1973 Prot. Drilling & Log

Wayne

date well completed

firm name

county well located

LANDOWNER: George Mc Donald

Description of formations encountered

from

to

Box 1 Shubuta, Miss (mailing address)

sandy clay 0 6
Chalk 6 30
sand 30 67
interbedded on chalk

WELL LOCATION:

sec. 13 T 9 N R 9 S 5 miles S of Euentha (distance) (direction) (nearest town)

WELL PURPOSE: home (home, irrigation, municipal, industrial)

WELL COMPLETION DATA:

- (1) diameter (inches) 2"
(2) total depth (feet) 54'
(3) static water level (feet) 34' below top of ground
(4) casing steel 48' (material) (depth) 2" (size) If telescope see back.
(5) screen 5' 48' (length) (depth to top) 1/4" (size) (material) bshl S.S.
(6) pump 1 (HP) 6 (yield gpm) elec (type power)
(7) electric log no (yes or no)
(organization running log)

5' 1/4" bshl S.S.
screwnut on cas with
back wash valve on end
42' 1/4" drop pipe

CODED

(8) how well bottom plugged back wash valve


DRILLERS REMARKS:

would not produce in lower part of sand

REC 60 107

If well telescopes please sketch and show depths.

GROUND LEVEL

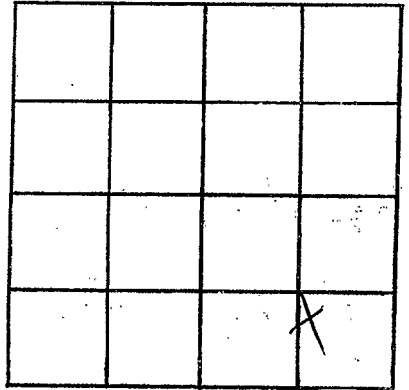

SECTION 13

Please indicate well location X.

ADDITIONAL INFORMATION

If more than one screen,
show locations of each on sketch.