

**WAYNE**  
**F 78**  
**5-4-73**

MISSISSIPPI  
 BOARD OF WATER COMMISSIONERS  
 416 North State Street  
 Jackson, Mississippi 39201

**CODED**

**WATER WELL DRILLERS LOG**

5-4 1973 J.R. GREEN WATER WELL WAYNE  
 date well completed firm name county well located

LANDOWNER:	description of formations encountered	from	to
<u>JAMES BROWN LEE</u>	<u>WHITE CHALK</u>	<u>0</u>	<u>10</u>
<u>R3 SHUBUTA MISS.</u> (mailing address) <u>39360</u>	<u>" "</u>	<u>10</u>	<u>15</u>
<u>WELL LOCATION:</u> sec <u>11</u> T <u>9</u> N R <u>9</u> W	<u>RED SAND</u>	<u>20</u>	<u>30</u>
<u>22</u> miles <u>NW</u> of <u>WAYNESBORO</u> (distance) (direction) (nearest town)	<u>WHITE CHALK</u>	<u>30</u>	<u>38</u>
<u>WELL PURPOSE:</u> (home, irrigation, municipal, industrial)	<u>" "</u>	<u>40</u>	<u>50</u>
<u>WELL COMPLETION DATA:</u>	<u>WHITT SAND</u>	<u>50</u>	<u>60</u>
(1) diameter (inches) <u>4"</u>	<u>" "</u>	<u>60</u>	<u>70</u>
(2) total depth (feet) <u>70</u>	<u>WHITE CHALK</u>	<u>70</u>	
(3) static water level (feet) <u>47</u> below top of ground.			
(4) casing <u>PVC</u> <u>60</u> (material) (depth)			
(size) if telescope see back.			
(5) screen <u>10'</u> <u>60'</u> (length) (depth to top)			
<u>2</u> <u>PVC</u> (size) (material)			
(6) pump <u>NONE</u> <u>NO CHECK</u> (HP) (yield gpm)			
<u>NONE</u> (type power)			
(7) electric log <u>NO</u> (yes or no)			
(organization running log)			
(8) how well bottom plugged			


**CODED**

DRILLERS REMARKS:  
*This well was drilled to test quality and quantity of water to be used*

NOV 23 1973

If well telescopes please sketch and show depths.

GROUND LEVEL

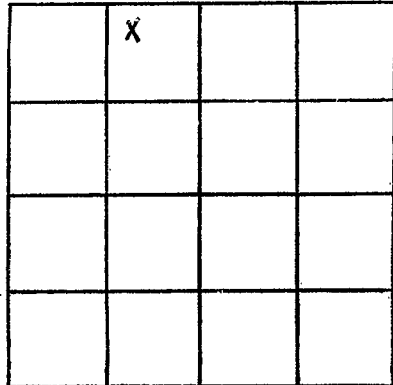

NE  $\frac{1}{4}$  OF NW  $\frac{1}{4}$

SECTION 11

Please indicate well location X.

ADDITIONAL INFORMATION

*in new home*

*well was drilled, cased and pumped until water closed.*

*Yeast sample was made. the water was salt (equal to sea water)*

*Plans for the new home had to be changed.*

*Casing was pulled and hole plugged.*

*Your Report & Salt Water Information on water well is attached.*

*water sample is available*

If more than one screen, show locations of each on sketch.

*J. R. New*