

WAYNE  
F81  
7-73

MISSISSIPPI  
BOARD OF WATER COMMISSIONERS  
416 North State Street  
Jackson, Mississippi 39201

**CODED**

WATER WELL DRILLERS LOG

JULY 1973 JR GREEN WATER WELL WAYNE  
date well completed firm name county well located

LANDOWNER:  
LARRY HANCOCK  
P.O. BOX 39360  
(mailing address)

WELL LOCATION:  
sec. 11 T. 9 N R. 9 E  
4 miles S of ESCOTTA  
(distance) (direction) (nearest town)

WELL PURPOSE:  
(home, irrigation, municipal, industrial)

WELL COMPLETION DATA:  
(1) diameter (inches) 4"  
(2) total depth (feet) 105  
(3) static water level (feet) 29 below top of ground.  
(4) casing PVC 70 (material) (depth)  
(size) if telescope see back.  
(5) screen 10 (length) 60 (depth to top)  
2 008 PVC (size) (material)  
(6) pump 1/2 (HP) 4 (yield gpm)  
110 VAC (type power)  
(7) electric log NO (yes or no)  
(organization running log)  
(8) how well bottom plugged

description of formations encountered	from	to
RED SAND	0	10
WHITE CHALK	10	20
FINE SAND	20	30
" "	30	40
" "	40	48
BLUE CHALK	48	50
" "	50	60
" "	60	64
BLUE SAND	64	70
BLUE CHALK	70	80
" "	80	90
" "	90	100
" "	100	105

**CODED**


SEP 3 1973

DRILLERS REMARKS:

MISS. DD. 012  
MAY 1973

If well telescopes please sketch and show depths.

GROUND LEVEL

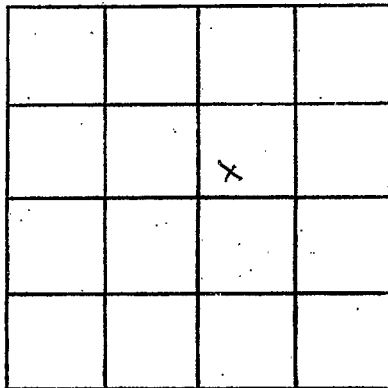

SE  $\frac{1}{4}$  OF NW  $\frac{1}{4}$

SECTION 11

Please indicate well location X.

ADDITIONAL INFORMATION

If more than one screen,  
show locations of each on sketch.