

WAYNE
F82
10-24-73

MISSISSIPPI
BOARD OF WATER COMMISSIONERS
416 North State Street
Jackson, Mississippi 39201

WATER WELL DRILLERS LOG

Oct 24 1973 Key W Well Water Wells Wayne
date well completed firm name county well located

LANDOWNER: Olinor Johnson

description of formations encountered

from to

RT 6
Laurel
(mailing address)

Clay	0	16
loamy clay	16	30
Clay	30	90
Sandy Clay	90	116
Sand	116	130
Clay	130	224
Lime rock	224	260

WELL LOCATION:

sec. 18 T 9 N R 9 E
5 miles E of Laurel
(distance) (direction) (nearest town)

WELL PURPOSE: Home
(home, irrigation, municipal, industrial)

WELL COMPLETION DATA:

- (1) diameter (inches) 2 1/2
- (2) total depth (feet) 260
- (3) static water level (feet) 80 below above top of ground.
- (4) casing PVC, 224,
(material) (depth)
if telescope see back.
- (5) screen 25, 224
(length) (depth to top)
1-1/4, plastic
(size) (material)
- (6) pump 1, 7
(HP) (yield gpm)
R.E.A.
(type power)
- (7) electric log No
(yes or no)
(organization running log)
- (8) how well bottom plugged inst. sealed

CODE 1


NOV 19 1973

DRILLERS REMARKS:

MISS. BD. OF
WATER DRILLING

If well telescopes please sketch and show depths.

GROUND LEVEL

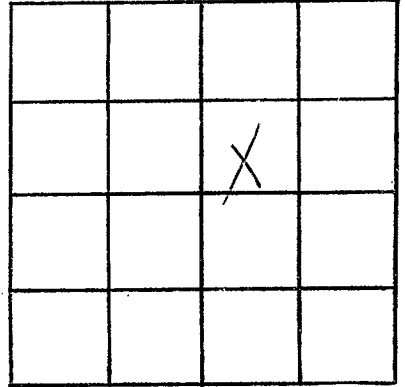

SECTION 15

Please indicate well location X.

ADDITIONAL INFORMATION

If more than one screen,
show locations of each on sketch.